


Section 10 Township 35 Range 3W

Well No. #2 Hudson

Company Texas

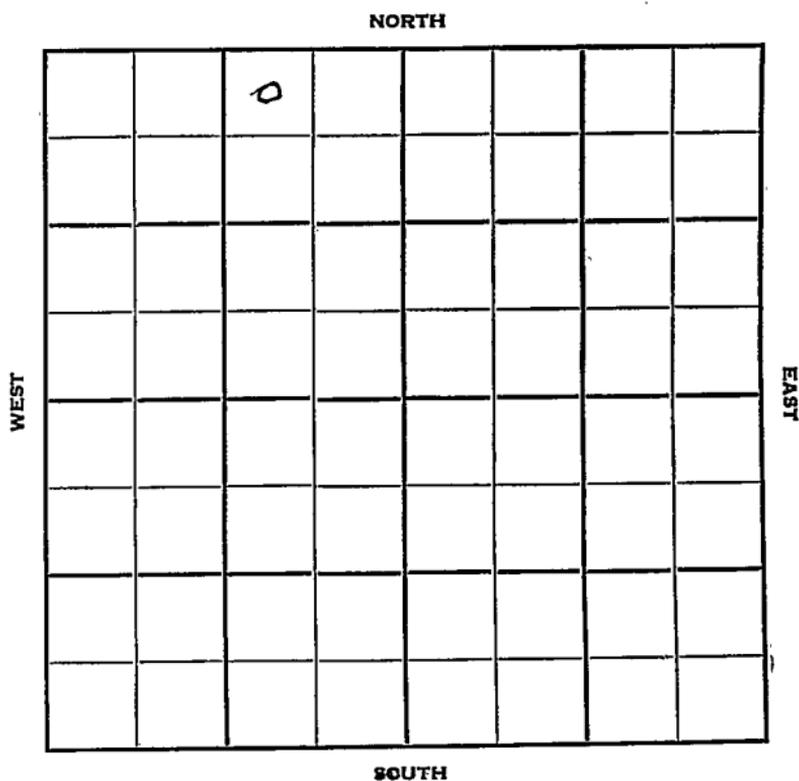

Sec. 10 Twp. 35 R. 3W

Well No. #2 Hudson Farm

Texas

Company

Stickle Drlg. - Contr.

Contractor

Fall Creek Pool


330' Ft. from N. Line

_____ Ft. from S. Line

990' Ft. from E. Line

_____ Ft. from W. Line

NW NE NW

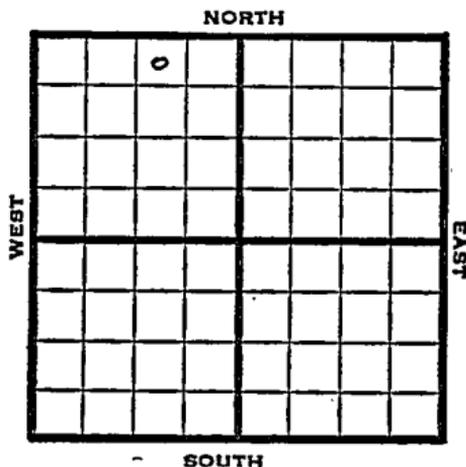

1951 Elev. 1121' REPORT

2/28 Spud 2-24-51
10" @ 584

5/2 Spud 2-24-51
Oil Well TD 4797
10" @ 584
KC 3618 Miss. 4322
Kinderhook 4688
Misenor 4737
Viola 4749
Simp 4762
Sand 4779
DST 4784-93 opn 1 hr. gas in 5 min.
oil in 58 min. TD 4797
7" @ 4790 19/4765-70
24/4774-80 2000 A F/221 bo 8½ hr
F/31 bo 2 hr Comp. 1168 bopd

COMPLETED

County Summer State Kansas

Sec. 10 (Blk.) 35 (Sur.) 3W Map No.

Operator Texas

Well No. 2 Farm Hudson

Elev. _____ Location NW NE NW

		0				

530 Ft. From N Line NW

990 Ft. From E Line Quarter

lst. Report FEB 28 1951

Completion _____

Remarks _____

Stickle Drlg. - Contr.

Spudding Date 2-24-51

Drlg. Data Fall Creek Pool

10" @ 584

County Sumner State Kansas

Sec. 10 (Blk. 35 (Sur. Rge.) 3W Map No.

Operator Texas

Well No. 2 Farm Hudson

Elev. 1121 Location NW NE NW

		0			

330 Ft. From N Line NW

990 Ft. From E Line Quarter

Ist. Report

Completion MAY 2 1951

Remarks Fall Creek Pool

Stickle Drlg. - Contr.

Spudding Date 2-24-51

Drlg. Data Oil well TD 4797

10" @ 584 KC 3618 Miss. 4322

Kinderhook 4688 Misenor 4737 Viola 4749

Simp. 4762 sand 4779 DST 4784-93

open 1 hr. gas in 5 min. oil in 58 min.

TD 4797 7" @ 4790 19/ 4765-70

24/ 4774-80 2000 A F/ 221 bo 8½ hr.

F/ 31 bo 2 hr. Comp. 1168 bopd

J. E. TYRA