

Sumner

KANSAS

Section 10 Township 35 Range 3WWell No. #1 HudsonCompany Texas Co.

NORTH

WEST	6							
EAST								

SOUTH

Summer

KANSAS

Sec. 10 Twp. 35 R. 3W

Well No. #1 Hudson Farm

Texas Co. Company

Stickle Drlg. - Contr. Contractor
Fall Creek Pool


330' Ft. from N. Line

 Ft. from S. Line

 Ft. from E. Line

330' Ft. from W. Line

NW NW NW

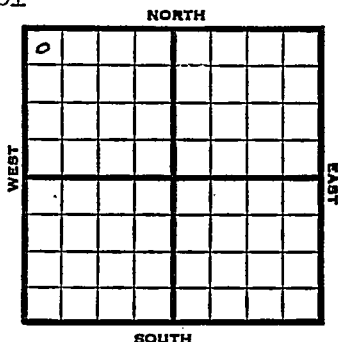

1950

Elev. 1125' REPORT

12/20

Spud 12-16-50
10-3/4" @ 583'
Drlg. 675'

1951
2/7

Spud 12-16-50
Oil well TD 4786
10-3/4" @583 Layton 3570 KC 3618
Miss. 4327 Kinderhook 4643 Viola 4730
DST 4739-86 open 15 min. gas in 6 min
oil in 12 min. Simp. 4744
7" @4776 TD 4786 F/ 330 bo 8 hr.
Comp. 5954 bopd

COMPLETED

County Sumner State Kansas
 Sec. 10 (Blk. Twp.) 35 (Sur. Rge.) 3W Map No. _____
 Operator Texas Company
 Well No. 1 Farm Hudson
 Elev. _____ Location NW NW NW

0							

FIRST REPORT

330 Ft. From N Line NW
330 Ft. From W Line Quarter

1st. Report DEC 20 1950

Completion _____

Remarks _____

Stickle Drlg. - Contr.

Spudding Date 12-16-50

Drlg. Data Fall Creek Pool

10 3/4" @ 583 drlg. 675

J. E. TYRA

County Summer State KansasSec. 10 (Blk. Twp.) 35 (Sur. Rge.) 3W Map No.Operator TexasWell No. 1 Farm HudsonElev. 1125 Location NW NW NW

10									

330 Ft. From N Line NW330 Ft. From W Line Quarter

1st. Report

Completion FEB 7 1951Remarks Fall Creek PoolStickle Drlg. - Contr.Spudding Date 12-16-50Drlg. Data Oil well TD 478610 3/4" @ 583 Layton 3570 KC 3618Miss. 4327 Kinderhook 4643 Viola 4730DST 4739-86 open 15 min. gas. in 6 min.oil in 12 min. Rimp. 4744 7" @ 4776TD 4786 F/ 330 bo 8 hr.Comp. 5954 bopd

J. E. TYRA