


Section 10 Township 35 Range 3W

Well No. #4 Hudson

Company Texas Co.

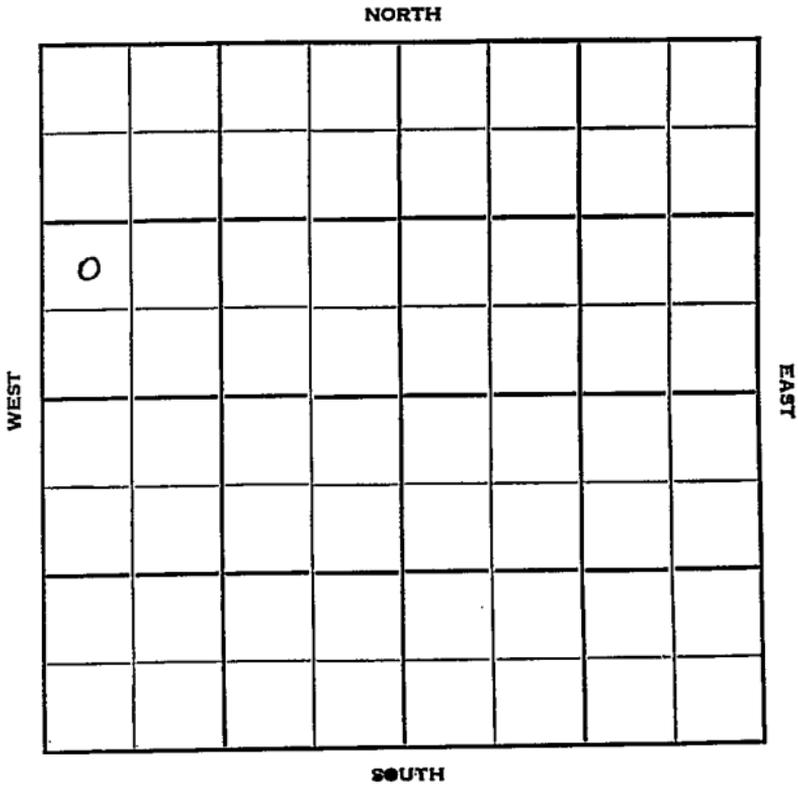

Summer **KANSAS**

Sec. 10 Twp. 35 R. 3 W

Well No. # 4 Hudson Farm

Texas Company Company

Contractor

Fall Creek Pool


Ft. from N. Line

990 Ft. from S. Line

Ft. from E. Line

330 Ft. from W. Line

NW SW NW

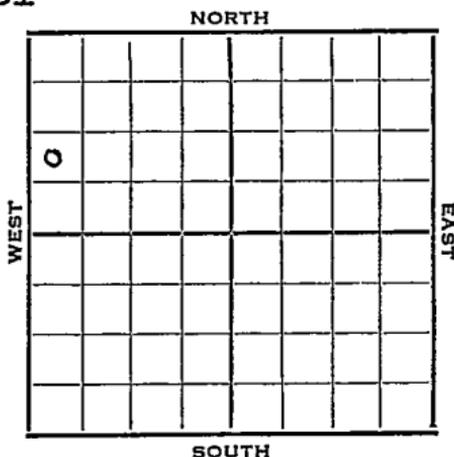

1951 Elev. 1123' REPORT

11/21 RUR

1952

1/30 Spud 11-20-51

Oil Well TD 4812

10" @ 602

KC 3655 Miss 4343

Kh 4700 Viola 4760

Simp. 4771 TD 4812

7" @ 4811

24/4803-09 1000 A F/128 bopd

Comp. F/130 bopd

COMPLETED

County Sumner State Kansas
 Sec. 10 (Blk. 35) (Sur. 3W) (Twp.) (Rge.) Map No.

Operator Texas Company

Well No. 4 Farm Hudson

Elev. 1123 Location NW SW NW

990 Ft. From S Line NW
330 Ft. From W Line Quarter
 Ist. Report
 Completion JAN 3 1952
 Remarks Fall Creek Pool

Spudding Date 11-20-51

Drilg. Data Oil well TD 4812

10" @ 602 KC 3655 Miss. 4343

Kh. 4700 Viola 4760 Simp. 4771

TD 4812 7" @ 4811 24/ 4803-09

1000 A F/ 128 bopd

Comp. F/ 130 bopd

J. G. McGEHEE