


DX 78-1

Morton KANSAS

Section 11 Township 35 Range 43W

Well No. 1 Jones

Company Musgrove Petr.

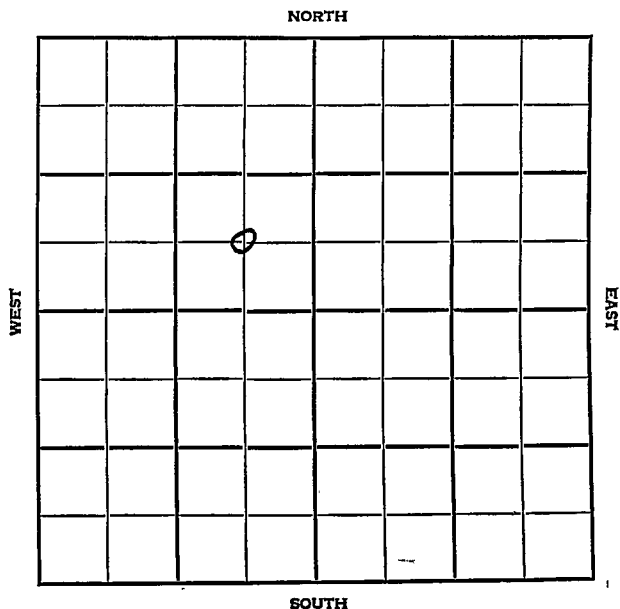

SEC.	TWP.	R.
11	35	43W

WELL NO.

1 Jones

FARM

COMPANY

Musgrove Petr.

CONTRACTOR.

Musgrove
Wildcat

Ft. from N. Line


660

Ft. from S. Line

660

Ft. from E. Line

Ft. from W. Line

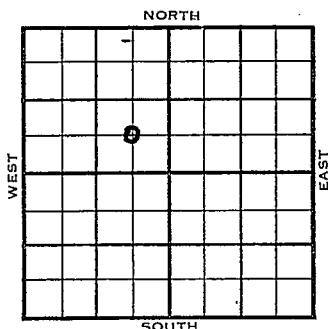C SE NW
PEPL FO

	ELEVATION	REPORT
1955	3627 KB	
4/20	Spud 4-18-55 Drlg. 428'	Miss Test
6/8	Comm 4-18-55 Anh Waub 2666 Tp 2867 L 3094 KC Marm 3537 BKC Atoka 3907 Ce Morr Sh 4106 C. Keys 4567 Miss TD 4712	2667 2863 3112 3541 3909 4184 4557 4634 4713
13" @ 320/250 8 5/8" @ 1331/225 DST 2666-2771 open 1 hr Rec 20' mud 225/20" DST 2867-2950 open 1 hr gas in 2 min 391 mcfg 700 mcfg Rec 360' gcm 465/20" DST 2 962-3010 open 45 mi gas in 30 sec 537, mcfg Rec 90' gcm 510/20" DST 3093-3170 open 1 hr Rec 265 sgcm 510/15" DST 3545-3650 open 1 hr Rec 390 gcmsw 700/15" DST 4530-70		

OVER

6/8 open $1\frac{1}{2}$ hr gas in 6 min, 3,120 mcfg
15 min 1,250 mcfg 90" Rec 100' mud
880# DST 4593-4615 open 1 hr Rec
1560' sw 180' ocm 120' socmsw 780/15"
5" @ 4619 CO to 4575 56/4558-72
1,400 mcfg 250 A frac
1,597 mcfg 8 gwpm CO to 4595 frac
250 M-A
Comp 2,579 mcfgpd 868#

COMPLETED

County Morton State KansasSec. 11 (Blk.) 35 (Sur.) 43W Map No. 1
(Twp.)Operator Musgrove Pet.Well No. 1 Farm JonesElev. Location C SE NW

FIRST REPORT

660 Ft. From S Line NW660 Ft. From E Line Quarter1st. Report APR 20 1955Completion Remarks PEPL farmoutMusgrove - Contr.Spudding Date 4-18-55Drlg. Data Miss. test Wildcatdrlg. 428

FABEN GILSTRAP

APR 26 1955

Scout Cards	42
Land Small Map	
Land Wall Map	5
Tracing	
France Map	
Pierce Map	
MISC.	

Orig. Data

County Morton ✓ Elev. 3627 KB
 Sec. 11 Twp. 35 Rge. 43W
 Company Musgrove Pet.
 FarmName Jones No. 1

TOPS	DEPTH	LOG	DATUM	Loc. in Sec.
Anh. <u>Waub</u>	<u>2666</u>	<u>2667</u>		<u>C SE NW</u>
Tr.	<u>2867</u>	<u>2863</u>		
H.				
Tr.				
Dg.				
BL.				
L.	<u>3094</u>	<u>3112</u>		
K.C. <u>Morm</u>	<u>3537</u>	<u>3541</u>		Geol.
B.K.C. <u>Atoka</u>	<u>3909</u>	<u>3909</u>		Contr.
C. <u>Norr Sh</u>	<u>4106</u>	<u>4184</u>	<u>557</u>	
C. <u>Keyes</u>	<u>4567</u>	<u>4557</u>	<u>930</u>	
M. <u>iss</u>		<u>4634</u>	<u>1007</u>	
M.				Pool
K.				<u>Wildcat</u>
Mz.				
Me.				
V.				
S.				
S.				
A				
R.				
Pe.				
G.				
TD.	<u>4712</u>	<u>4713</u>		

COMPLETE

Date Comm. 4-18-55 JUN 8 1955

13" @ 320/250 8 5/8" @ 1331/225

DST 2666-2771 open 1 hr. Rec. 20' mud

225/20" DST 2867-2950 open 1 hr.

gas in 2 min. 391 mcfg 700 mcfg

Rec. 360' gcm 465/20" - DST 2962-3010

open 45 min. gas in 30 sec. 537,mcfg

Rec. 90' gcm 510/20" DST 3093-3170

open 1 hr. Rec. 265' sgcm 510/15"

OVER

JUN 27 1955

Scout Cards h h c
Land Small Map _____
Land Wall Map _____
Tracings _____
France Map _____
Pierce Map _____
Misc. _____

DST 3545-3650 open 1 hr. Rec. 390'
gcmw 700/15" DST. 4530-70 open 1 $\frac{1}{2}$ hr.
gas in 6 min. 3,120 mcfg 15 min. 1,250
mcfg 90" Rec. 100' mud 880#
DST. 4593-4615 open 1 hr. Rec. 1560' sw
180' ocm 120' socmsw 780/15" 5" @ 4619
CO to 4575 56/4558-72 1,400 mcfg
250 A trac 1,597 mcfg. 8 gwpn
CO to 4595 trac 250 M-A
Comp. 2,579 mcfgpd 868#