


Section 11 Township 35 Range 40 W

Well No. # 1 Withroder

Company Panhandle Eastern Pipe Line Co.

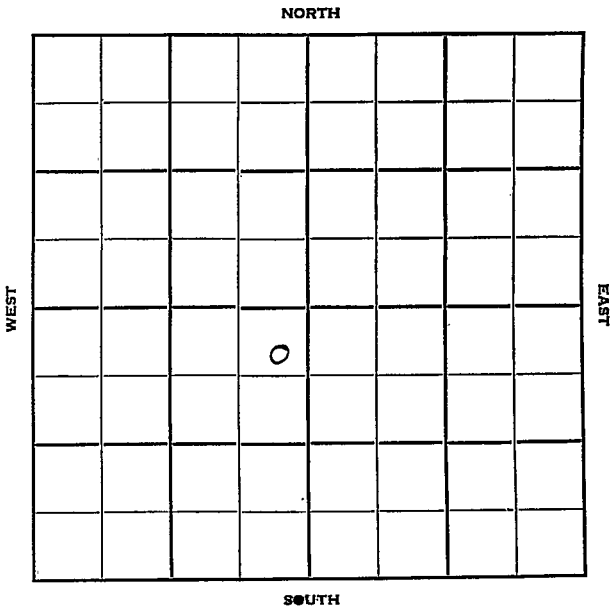

Morton

KANSAS

Sec. 11 Twp. 35 R. 40 W

Well No. # 1 Withroder Farm

Panhandle Eastern Pipe Line Company

Kuhn Contractor

Hugoton Pool


485 Ft. from N. Line

_____ Ft. from S. Line

201 Ft. from E. Line

_____ Ft. from W. Line

NE NE SW

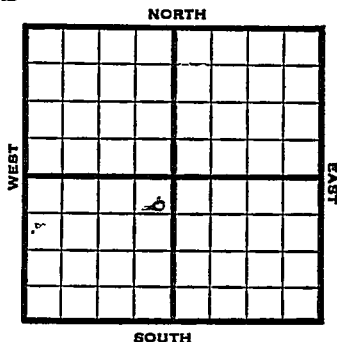

1951 Elev. 3388' REPORT

6/27 R U R

11/21 Spud 6-28-51

Gas Well TD 2746

10" @ 514 7" @ 2550 TD 2746

Hol 2511 Her. 2559 Kri. 2582

Win. 2657 Ft. Riley 2727

19000 A

Comp. 14,082,000 gas

COMPLETED

~~J. E. TYRRE~~

J. E. TYRA