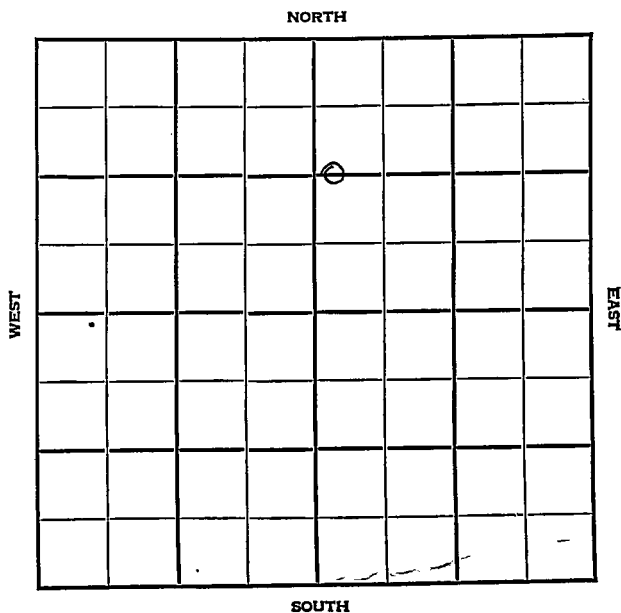


Section 11 Township 35 Range 37WWell No. 1 R. BrownCompany Republic Natural Gas

Sec. 11 Twp. 35 R. 37WWell No. #1 R. Brown FarmRepublic Natural Gas Company

Houghton Pool

1320 Ft. from N. Line


Ft. from S. Line

Ft. from E. Line

100 Ft. from W. Line

CWL NE

SW NE

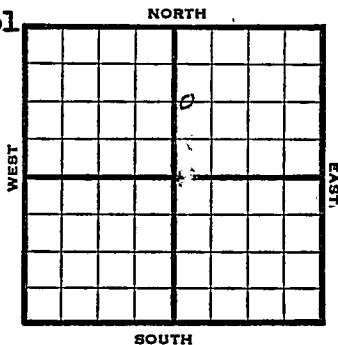

1948

E₁ 3113'

REPORT

4/21

10" @ 695'

Drlg. 2397'

4/28

TD 2668'

7" @ 2660'

5/5

"

5/12

"

5/19

TD 2837'

5/26

TD 2875'

228' of 5" perf. liner @ 2875'

6/1

"

6/9

3000 Acid

6/16

Total 20,000 acid

6/23

TD 2875'

7" @ 2660

228' of 5" liner @ 2875'

2000 acid

27,917,000 gas

388# R pr.

Comp.

COMPLETED

Map No. _____ Sec. 11 Twp. 35 R. 37W

Well No. 1 R. Brown

Republic Natural Gas Company

COMPLETE

Contractor

C W L NE.


5/13/13
SECTION PLAT

1320 Ft. from N. Line

_____ Ft. from S. Line

_____ Ft. from E. Line

100 Ft. from W. Line

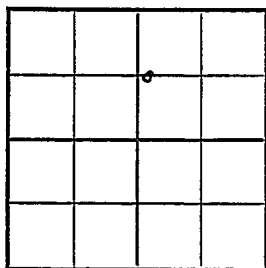

Stevens County

RECORD

Location _____

Cased _____ in., _____ ft.

Rig up _____

Sand _____

Drilling and Remarks:

Gas _____

7' @ 2660

Oil _____

225' of 5" liner

Total Depth 2825'

@ 2875'

20000 acf

27,817,000 cu

PRODUCTION

1st 24 hrs. Nat. _____

1st 24 hrs. after shot _____

Gas _____ Cu. Ft.

Dry Hole _____

Abandoned _____

388' R.R.

Date

JUN 23 1948 19 S. J. LEWIS Scout

Map No. _____ Sec. 11 Twp. 35 R. 37WWell No. I R. BrownRepublic Natural Gas Company**CORRECTION**

Contractor

C W L NE

SECTION PLAT

		o	

1320 Ft. from N. Line Ft. from S. Line Ft. from E. Line100 Ft. from W. Line

Stevens County

Location _____

Rig up _____

Drilling and Remarks:

Reported /

SW NE

RECORD

Cased _____ in., _____ ft.

Sand _____

Gas _____

Oil _____

Total Depth _____

PRODUCTION

1st 24 hrs. Nat. _____

1st 24 hrs. after shot _____

Gas _____ Cu. ft.

Dry Hole _____

Abandoned _____

Date

APR 28 1948 19

S. J. LEWIS

Scout

Map No. _____ Sec. 11 Twp. 35 R. 37WWell No. 1 R. BrownRepublic Natural Gas Company**FIRST REPORT**

Contractor _____

SW NE

SECTION PLAT

1320 Ft. from N. Line

_____ Ft. from S. Line

_____ Ft. from E. Line

100 Ft. from W. Line

Stevens County

Location _____

Rig up _____

Drilling and Remarks:

10" @ 695

drlg. 2397

RECORD

Cased _____ in., _____ ft.

Sand _____

Gas _____

Oil _____

Total Depth _____

PRODUCTION

1st 24 hrs. Nat. _____

1st 24 hrs. after shot _____

Gas _____ Cu. Ft.

Dry Hole _____

Abandoned _____

Date

APR 21 1948 19 S. J. LEWIS Scout