

KANSAS


Stevens

Section 11 Township 35 Range 35-WWell No. #1 BolesCompany Plains Natural Gas

NORTH

WEST

EAST

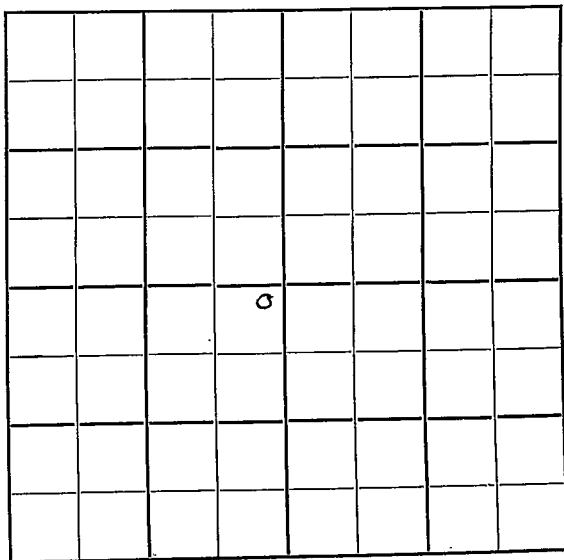

SOUTH

KANSAS

Stevens

Sec. 11 Twp. 35 R. 35-W

Well No. #1 Boles

Farm

Plains Natural Gas

Company

Contractor

Hugoton

200

Ft. from N. Line


Ft. from S. Line

200

Ft. from E. Line

Ft. from W. Line

NE SW

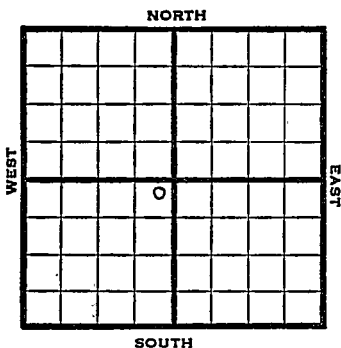

1950

Elev. 2963' REPORT

7/19

Spud 7-15-50  
10" @ 479  
Drilg 1746

9/20

Spud 7-15-50  
Gas Well TD 2788'  
10" @ 479' 7" @ 2780'  
Hol. 2589' Her. 2651'  
Krider 2680' Win. 2766'  
CO to 2764'  
30/2653-58 48/2660-68  
60/2683-93 78/2700-13  
30/2772-77  
23,000 Total acid  
Comp. 2,453,000 gas 419  
**COMPLETED**

Kan<sup>7999</sup>Map No. \_\_\_\_\_ Sec. 11 Twp. 35 R. 35WWell No. 1 BolesPlains Natural Gas Company

Contractor

NE SW

## SECTION PLAT

200 Ft. from N. Line

\_\_\_\_\_ Ft. from S. Line

200 Ft. from E. Line

\_\_\_\_\_ Ft. from W. Line

Stevens County

Location \_\_\_\_\_

Rig up \_\_\_\_\_

Drilling and Remarks:

Spud 7-15-50

10" @ 479

drlg. 1746

## RECORD

Cased \_\_\_\_\_ in., \_\_\_\_\_ ft.

Sand \_\_\_\_\_

Gas \_\_\_\_\_

Oil \_\_\_\_\_

Total Depth \_\_\_\_\_

## PRODUCTION

1st 24 hrs. Nat. \_\_\_\_\_

1st 24 hrs. after shot \_\_\_\_\_

Gas \_\_\_\_\_ Cu. Ft.

Dry Hole \_\_\_\_\_

Abandoned \_\_\_\_\_


Date

JUL 19 1950

19

J. E. TYRA Scout

County Stevens State Kansas  
 Sec. 11 (Blk. 35 (Sur. 35W Map No.  
 Operator Plains Natural Gas  
 Well No. 1 Farm Boles  
 Elev. 2963 Location NE SW

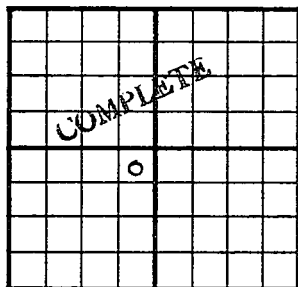

200 Ft. From N Line SW

200 Ft. From E Line Quarter

1st. Report

Completion SEP 20 1950

Remarks

Hugoton Pool

Spudding Date 7-15-50

Drlg. Data Gas well TD 2788

10" @ 479 7" @ 2780 TD 2788

Hol. 2589 Her. 2651 Krider 2680

Win. 2766 ~~TD~~ to 2764 30/ 2653-58

48/ 2660-68 60/ 2683-93 78/ 2700-13

30/ 2772-77 23000 total acid

Comp. 2,453,000 gas 419#