


Section 11 Township 35 Range 32 W

Well No. # 1 Light "C"

Company Jomilson

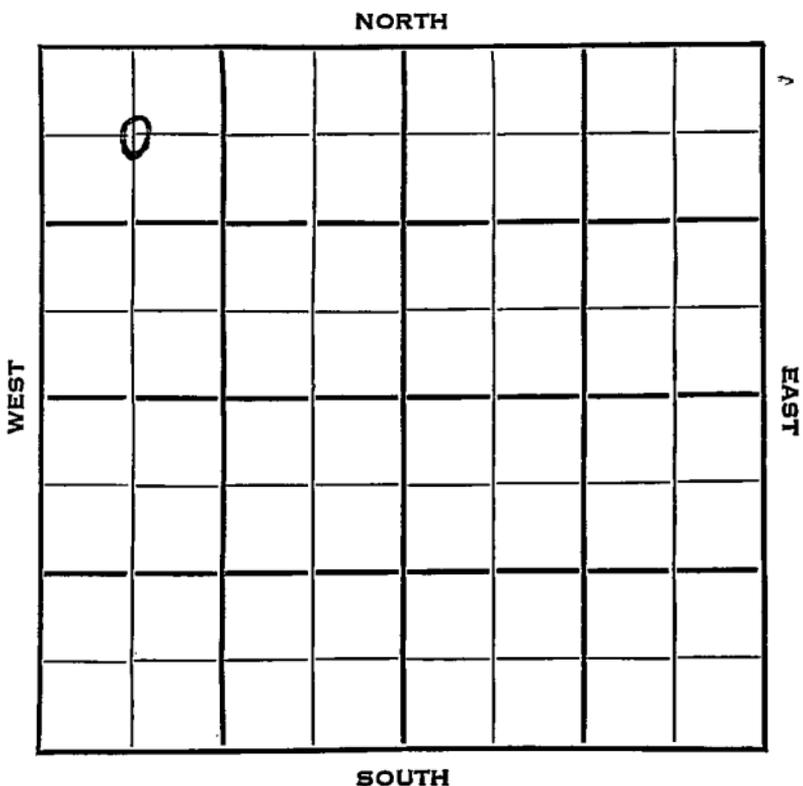

SEC.	TWP.	R.
11	35	32 W ✓

WELL NO.

1 Light "C"

FARM

COMPANY

Jemilson

CONTRACTOR


660 Ft. from N. Line

Ft. from S. Line

Ft. from E. Line

660 Ft. from W. Line

C NW NW

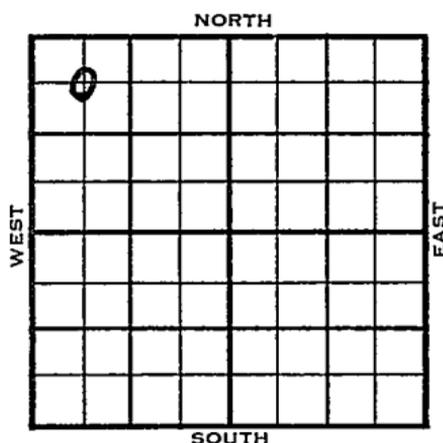

1953

ELEVATION

2753'

REPORT

10/14

Spud 10-2-53

13" @ 605 8" @ 2392

Drlg. 2474'

10/21

Drlg 3624'

10/28

Drlg 5047'

11/4

Drlg 5874'

12/2

Spud 10-2-53 D & A TD 6248'

13" @ 605 8" @ 2392

DST 5853-6016 open 3/4 hr,
rec 5 gal mud.

DST 5925-6058' failed.

DST 5856-6058' open 1 hr rec 90' mud

DST 6061-6138' open 30 min, rec 8' mud

TD 6138' PB 6025 PB 4954'

DD 6248'

DST 6127-5248' open 35 min, rec 40'
mud, Off 5" @ 5235 CO to 5163

16/5127-29 Her. 2622 Kri. 2653'

Win. 2750' Ft. Riley 2809'

Lans. 4598' Marm. 5295' Morrow

5925' Chester 6145'

DST 5127-29 open 1 1/2 hr, rec 150' oily
mud & 2750' SW 1575# PB 5122

12/5109-12

DST 5109-12, failed. PB 5105

40/5094-5104 500 A 16/4595-99

1953

12/2

(Information continued)

FU 1000' oily SW. S/100' oily SW

PB 4930 8/4907-09 PB 4900

32/4890-98 S/oily mud. 500 A

F & A

ABANDONED

County **Seward** State **Kansas**

Sec. **11** (Blk. Twp.) **35** (Sur. Rge.) **32W** Map No.

Operator **Jemilson**

Well No. **1** Farm **Light "C"**

Elev. **2753** Location **C NW NW**

0					

660 Ft. From **N** Line **NW**

660 Ft. From **W** Line **Quarter**

1st. Report **OCT 14 1953**

Completion

Remarks

Spudding Date **10-2-53**

Drlg. Data

13" @ 605 8" @ 2392 drlg. 2474

Scout Cards	mm
Land Small Map	
Land Wall Map	3
Tracings	
France Map	
Pierce Map	
Misc.	

OCT 16 1953

Orig. Data

County Seward State Kansas
 Sec. 11 (Blk. 35) (Sur. 32W) Map No.
 Operator Jomilson
 Well No. 1 Farm Light "C"
 Elev. 2753 Location C NW NW

0					

660 Ft. From N Line NW660 Ft. From W Line Quarter

1st. Report

Completion DEC 2 1953

Remarks

Spudding Date 10-2-53Drig. Data D & A TD 624813" @ 605 8" @ 2392 DST 5853-6016open 3/4 hr. Rec. 5 gal. mud DST 5925-6058 failed DST 5856-6058 open 1 hr.Rec. 90' mud DST 6061-6138 open 30 min.Rec. 8' mud TD 6138 PB 6025 PB 4954DD 6248 DST 6127-5248 open 35 min.rec. 40' mud 0# 5" @ 5235 CO to 516316/ 5127-29 , Her. 2622 Kri. 2653Win. 2750 Ft. Riley 2809 Lans. 4598Marm. 5295 Morrow 5925 Chester 6145DST 5127-29 open 1 1/2 hr. Rec. 150' oilymud & 2750' sw 1575# PB 5122 12/ 510912 DST 5109-12 failed PB 510540/ 5094-5104 500 A 16/ 4595-99

J. G. MCGEHEE

Spot Cards	mmmm
Land Small Map	
Land Wall Map	5
Tracings	
France Map	
Florida Map	
Misc.	

8

1953

D & A

FU 1000' oily SW S / 100' oily SW
 PB 4930 8 / 4907-09 PB 4900
 32 / 4890-98 S / oily mud 500 A

Drig. Data