
FORM 51 25M 8-50 WESTERN Seward KANSAS

Section 11 Township 35 Range 32W

Well No. #1 Wieland

Company Jomilson

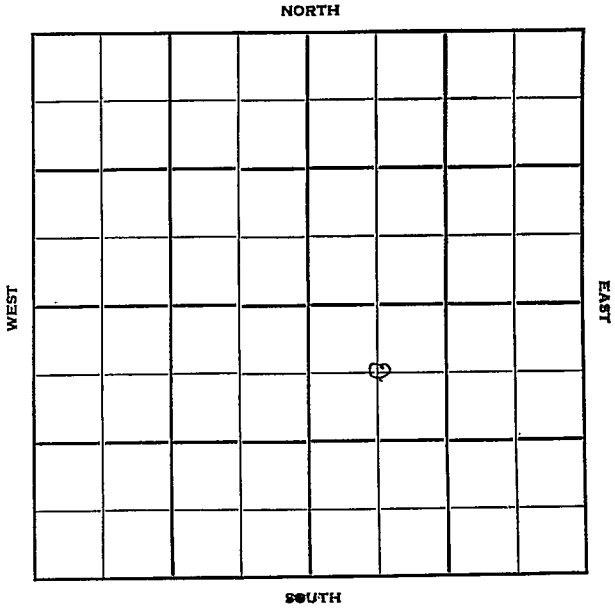

FORM 252-B
10M 8-51 TPCO.

Seward KANSAS

Sec. 11 Twp. 35 R. 32 W

Well No. # 1 Wieland Farm

Jomilson Company

Contractor


660 Ft. from N. Line

Ft. from S. Line

Ft. from E. Line

660 Ft. from W. Line

C NW SE

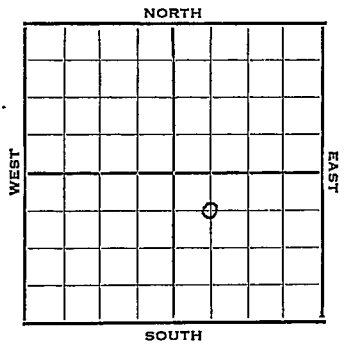

	REPORT
1951	Elev. 2746'
12/5	RUR
1952	
2/6	Drlg. 6615'
2/13	DST 6680-6737 ½ hr. 65' mud 2000# TD 6737 schl.
2/20	Drlg. 7385'
3/5	TD 7561 D&A Hold
3/12	"
3/19	Spud 12-6-51 D & A TD 7561' 13" @ 600 9" @ 2396 DST 2795-2855 open 1 hr, rec 308' SW Morrow 5949' DST 6110-6217 open ½ hr, rec 135' mud Chester 6225' DST 6372-6417 open 45 min, rec 250' mu DST 6680-6737 open ½ hr. rec 65' mud TD 6737' DST 7375-7516 open 1½ hr. rec 1600' salty muddy water. TD 7561' D & A Sch tops: KC 4464' Morrow sh. 5948' Miss. Chester 6224'

ABANDONED

FORM 275 FOR SALE BY KANSAS BLUE PRINT CO


County Seward State Kansas

Sec. 11 (Blk. Twp.) 35 (Sur. Rge.) 32W Map No.

Operator Jomilson

Well No. 1 Farm Wieland

Elev. Location C NW SE

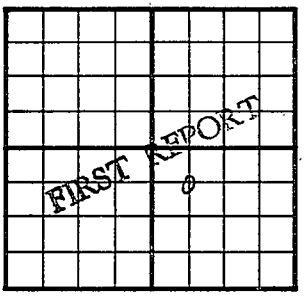

660 Ft. From N Line SE

660 Ft. From W Line Quarter

1st. Report DEC 5 1951

Completion

Remarks

Spudding Date

Drlg. Data

R U R

J. E. TYRA

FORM 275 FOR SALE BY KANSAS BLUE PRINT CO.


County Seward State Kansas

Sec. 11 (Blk. Twp.) 35 (Sur. Rge.) 32W Map No.

Operator Jomilson

Well No. 1 Farm Wieland

Elev. 2746 Location C NW SE

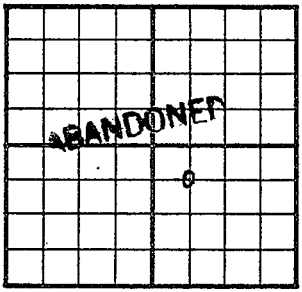

660 Ft. From N Line SE

660 Ft. From W Line Quarter

1st. Report

Completion MAR 1 0 1952

Remarks Light Pool

Spudding Date 12-6-51

Drlg. Data D & A TD 7561

13" @ 600 9" @ 2396 DST 2795-2855

open 1 hr. Rec. 308' sw Morrow 5949

DST 6110-6217 open ½ hr. Rec. 135' mud

Chester 6225 DST 6372-6417 open 45 min.

Rec. 250' mud DST 6680-6737 open ½ hr.

Rec. 65' mud TD 6737 DST 7375-7516

open 1½ hr. Rec. 1600' salty muddy water

TD 7561 D & A

Sch. tops: KC 4464 Morrow sh. 5948

Miss. Chester 6224

J. G. McGEHEE