


FORM 51 25M 8-50 WESTERN

Meade

Section 11 Township 35 Range 30W

Well No. #1 Adams "K"

Company Columbian Fuel

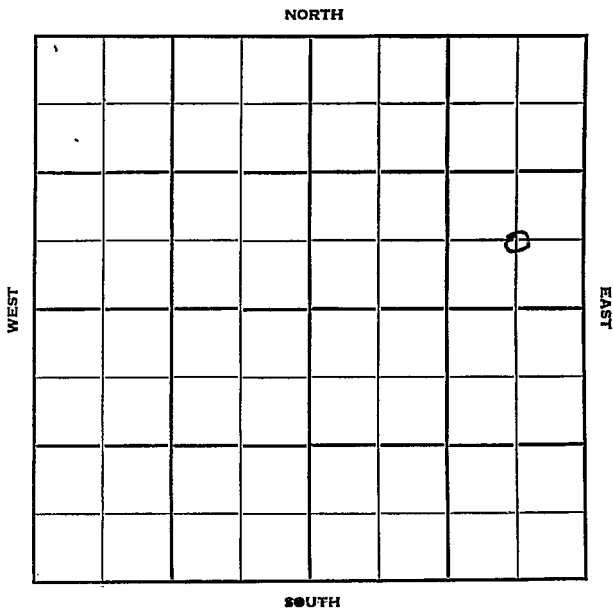

Meade

KANSAS

Sec. 11 Twp. 35 R. 30 WWell No. # 1 Adams "K" FarmColumbian Fuel Company

Contractor


Hugoton Pool

Ft. from N. Line

660 Ft. from S. Line660 Ft. from E. Line

Ft. from W. Line

G SE NE

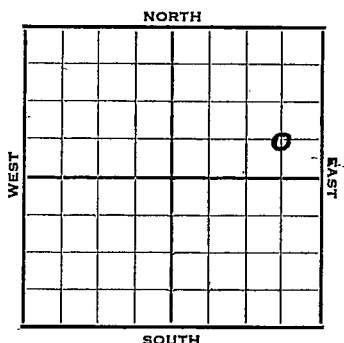

1952

Elev. 2441' REPORT

7/9 MIR
7/17 13" @ 654'
7/23 9" @ 2523'
7/30 Drlg. 2954'
8/6 DST 4320-54 1/2 hr. 5' M 975#
DST 4354-70 1 hr. 45' mcs w & 20' M
1200# Circu @ 4732
8/13 DST 5025-38, 1/2 hr. 270' SW
1710# F 5135-87 50' F 5188-5238
Drlg. 5423'
8/20 DST 4755-89 1 1/2 hr. 3' dist 37' GCM
1950# Drlg. 5893
8/27 Morrow 5726 RTD 6100' Schl.
9/3 5" @ 5826
9/10 NR
9/17 "
9/24 "
10/1 12/ 5780-82, sq. off
12/5742-44, sq. off CO
10/8 CO to 5774' 60/ 5760-70
2,323,000 gas SP 5750' Strato-frac.
2000 A 4,800,000 gas Stratofrac
sq. off.
10/15 "
10/22 CO

OVER

1952

10/29 -CO 5774'

11/5 Shut In

11/12 NR

11/19 Spud 7-12-52

Gas Well

TD 6100'

13" @ 654'

9" @ 2523

DST 4320-54, opn $\frac{1}{2}$ hr., rec.
5' mud, 975#

DST 4354-70, opn 1 hr., rec.
45' mcsw, 20' mud, 1200#

DST 5025038, opn $\frac{1}{2}$ hr., rec.
270' muddy sw, 1710#

DST-5755-89, opn $1\frac{1}{4}$ hrs.,
rec. 3' dist. 37' gcm, 1950#

Morrow 5726

TD 6100

5" @ 5826

12/5780-82, 12/5742-44,

CO to 5774, 60/5760-70,

2,323,000 gas, SP 5750

stratofrac, 2000A

4,800,000 gas stratofrac

CO to 5774

Perf / 5760-70, 2,300,000 gas,
SP 5752, s-frac

3,284,000 gas, 1 1/2

Well. 1927, Her. 2515, Kri.

2600, Win. 2615, Ft. Riley

2748', Penn. sh. 3655, KC

4345, Marm. 5150', Cherokee

5375, Miss. 5855

Comp. 3,714,000 gas

COMPLETED


J. G. McGEHEE

Scout Cards	mm
Land Small Map	
Land Well Map	B
Tracings	
France Map	
Pierce Map	
Misc.	

JUL 11 1952

Drig. Data

County Meade State Kansas
 Sec. 11 (Blk. Twp.) 35 (Sur. Rge.) 3 OW Map No. _____
 Operator Columbian Fuel
 Well No. 1 Farm Adams "K"
 Elev. 2441 Location C SE NE

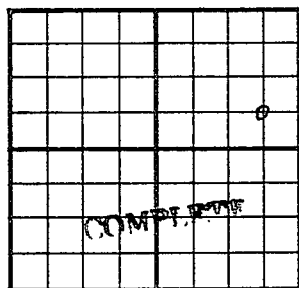

660 Ft. From S Line NE
660 Ft. From E Line Quarter
 1st. Report _____
 Completion NOV 19 1952
 Remarks Hugoton Pool
 Spudding Date 7-12-52

Drlg. Data Gas well TD 6100
13" @ 654 9"@ 2523 DST 4320-54
open $\frac{1}{2}$ hr. Rec. 5' mud 975#
DST 4354-70 open 1 hr. Rec. 45' mcs w
20' mud 1200# DST 5025-38 open $\frac{1}{2}$ hr.
Rec. 270' muddy sw 1710# DST 5755-89
open $1\frac{1}{2}$ hr. Rec. 3' dist. 37' gcm
1950# Morrow 5726 TD 6100 5" @ 5826
12/ 5780-82 12/ 5742-44 CO to 5774
60/ 5760-70 2,323,000 gas SP 5750
stratofrac 2000 A 4,800,000 gas
stratofrac CO to 5774 Perf/ 5760-70
2,300,000 gas SP 5752 s-frac
3,284,000 gas Well. 1927 Her. 2515
Kri. 2600 Win. 2615 Ft. Riley 2748

J. G. McGEHEE

Orig. Data

Penn. sh. 3655 KC 4345 Marm. 5150

Cherokee 5375 Miss. 5855

Comp. 3,714,000

Scout Cards	AD
Land Small Map	
Land Wall Map	33
Tracings	
France Map	
Pierce Map	
Misc.	

NOV 25 1952