

Meade


KANSAS

SECTION 11 TOWNSHIP 35 RANGE 27W

WELL NO. #1 Finch

COMPANY Monsanto

NORTH

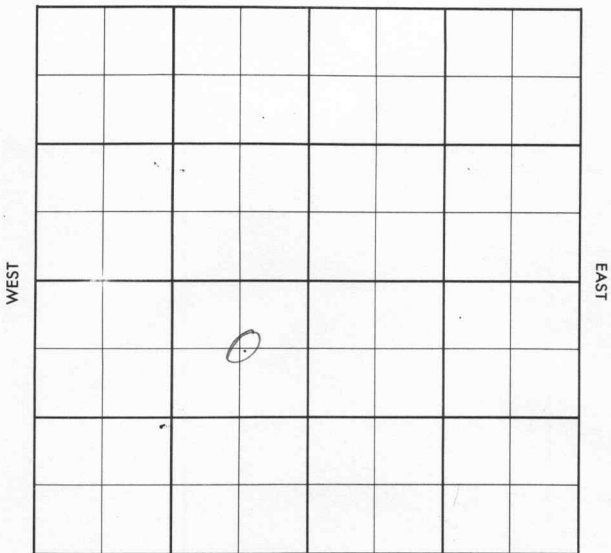

SOUTH

County Meade Elev. _____
 Sec. 11 Twp. 35 Rge. 27W
 Company Monsanto
 Farm Name Finch No. 1

TOPS	DEPTH	LOG	DATUM	Loc. in Sec.
Anh.				C NE SW
Top.				
H.				
Tr.				
Dg.				
Bl.				
L.				Geol. _____
K.C.				Contr. _____
B.K.C.				
Ce.				<u>Rine Drlg.</u>
C.				
M.				Pool _____
M.				<u>Fincham</u>
K.				
Mz.				
Me.				
V.				
S.				
S.				
A.				
R.				
Pe.				
G.				
TD.				

FIRST REPORT
 0
 DEC 12 '56

Date Comm. 12-9-56
drlg. 1410

(Large handwritten scribble)

Co.
Lse.
No.
Sec.
T.
R.

County Meade Elev. 2333
 Sec. 11 Twp. 35 Rge. 27W
 Company Monsanto
 Farm Name Finch No. 1

TOPS	DEPTH	LOG	DATUM	Loc. in Sec.
Anh. <u>Herr</u>	<u>2625</u>			<u>C NE SW</u>
Tp. <u>W Fd</u>	<u>2732</u>			
H.	<u>4527</u>			
Tr. <u>CO grove</u>	<u>3062</u>			
Dg.				
Bl.				
L.	<u>4715</u>			Geol.
K.C. <u>Marm</u>	<u>5456</u>			Contr.
B.K.C.				
Ce.	<u>5643</u>			<u>Rine Drlg.</u>
C. <u>Mush</u>	<u>6026</u>			
M. <u>chest</u>	<u>6158</u>			Pool
M. <u>" 3d</u>	<u>6561</u>			<u>Finchem</u>
K.				
Mz.				
Me.				
V.				
S.				
S.				
A.				
R.				
Pe.				
G.				
TD.	<u>6635</u>			

COMPLETE
 0
 JAN 30 '57

Date Comm. 12-9-56
 drlg. 1410 ^{DEC 19 '56} 85/8 15.56 / 900
DST 3108-20 lhr nec 370'
MSW FP 40-190 BHP 825/20"
112310 DEC 26 '56 115550 JAN 2 '57 115720
JAN 9 '57 116020 JAN 16 '57 ctd 6122-69
nec 39' (sk oil stain) DST 6216-30
lhr 6/44" nec 25' VSGCM BHP 2055
130" DST 6230-50 lhr 6/23" ga 180
MCF/45" nec 55' SGCM BHP 2135/40"

DST 6547-72 1hr see 630' GIP
 + 250' OEGCM BHP 290/30"
 5 1/2 6628/300 MCT JAN 22 '57 CO
 6596 112 / 6222-50 Ø 26W
 + 556 10 ga 4,350 MCF
 5 hr Test 24/64" ch FTP 975
 JAN 30 '57 Flw ga 3,650 MCF +
 30 BFPd. 28/64" ch FCP 1233#
 FTP 1155 cal op Flow 5 Mill.
 CFBPD