


Section 11 Township 35 Range 13W

Well No. #1 Achenbach

Company Huber et al & MCPC

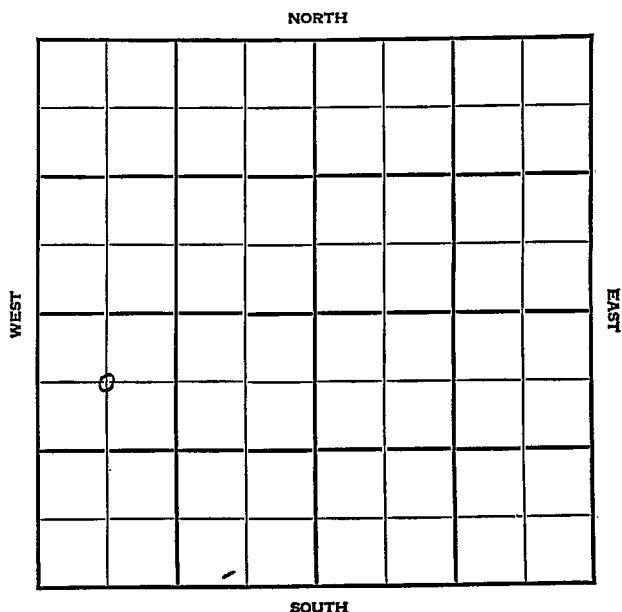

Sec. 11 Twp. 35 R. 13WWell No. #1 Achenbach Farm
Huber et al Mid-Continent Petr.
Company


Wildcat

Mr. W.J. Coppinger

NORTH

660 Ft. from N. Line660 Ft. from S. Line

Ft. from E. Line

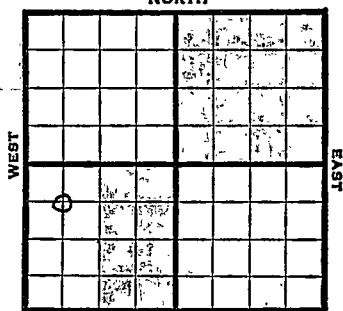660 Ft. from W. Line

C NW SW

OFFSET

SOUTH

1947

Elev. 1480 REPORT

	Arbuckle Lime Test Approx. 5600'
10/1	Location 1440 Acre Blk. Part in Okla. and part in Kansas.
10/8	"
10/16	Spud 10-15-47 10-3/4" casing at 560' (Wire)
10/21	Drilling 2135' (Huber)
10/22	Drilling 2385' "
10/23	Drilling 2600' "
10/24	Drilling 2835' "
10/27	Drilling 3602' (Wire)
10/28	DST 3705'-3717' .. Ft. Riley 2200' Open 15 mins. B. Florence 2350' Rec. 720' salt water Elgin 3705' Drilling 3790' B. Elgin 3856' (Wire)
10/31	Top Kansas City 4234' B. Woodford 2455' Drilling 4338' "
11/4	Mississippi 4841' T.D. 4855' Spotted dark staining and Chert. To take DST. (Wire)
11/5	DST 4843'-55' Open 20 mins. Rec. 15' mud, slightly gas cut (Huber) Toronto 3957' Douglas 4005' Douglas sd. 4020' Kansas City 4234' Porous Zones (oolitic lime) 4244'-55' no shows 4268'-75' no shows 4307'-12' no shows. (Huber) Mississippi 4841'

OVER

1947

- 11/7 Shut down 5600'
Putting on new drilling cable. (Tel)
- 11/10 Drilling 5250' (Huber)
- 11/12 Drilling 5375' in Viola.
Viola 5280' "
- 11/17 Top Arbuckle 5611'
Drilling 5636'
No porosity, no show
Ran Schl.
Want to plug. (Snider)

Additional tops:

T. Xln. Lime 5305'

T. Cherty Zone 5324'

Lower Lime 5394'-5412'

Top Simpson Shale 5412'

Top Sand 5426'-33' no sho; no odor.

Fairly poor sand to 5471' w/few hard
tight strks. (Huber)

- 11/19 Simp. 5412'
Simp. Sd. 5426'
Arb. 5611'
TD 5636'

ABANDONED

Map No. _____ Sec. 11 Twp. 35 R. 13W

Well No. 1 Achenbach

Huber et al. & MCPC Company

IRST REPORT

Contractor

C N^W SW

SECTION PLAT

b			

660 Ft. from N. Line

660 Ft. from S. Line

Ft. from E. Line

660 Ft. from W. Line

Barber County

Location X

Rig up _____

Drilling and Remarks:

RECORD

Cased _____ in., _____ ft.

Sand _____

Gas _____

Oil _____

Total Depth _____

PRODUCTION

1st 24 hrs. Nat. _____

1st 24 hrs. after shot _____

Gas _____ Cu. Ft.

Dry Hole _____

Abandoned _____

Date

OCT 1 1947 19

S. J. LEWIS Scout

~~Check test
measurement
line N or
green S line~~

[Large handwritten flourish]

Misc Small Maps	<i>[initials]</i>
Cards	<i>[initials]</i>
Tracing	<i>[initials]</i>
France Map	<i>[initials]</i>
Scarborough Map	<i>[initials]</i>
Pierce Map	<i>[initials]</i>
Geological Dept.	_____
Pierce Plat Book	_____

Kansas

Map No. 93 Sec. 11 Twp. 35 R. 13WWell No. 1 AchenbachHuber et al. Company

ABANDONED

Contractor

C NW SW

E11/480
SECTION PLAT660 Ft. from N. Line Ft. from S. Line Ft. from E. Line660 Ft. from W. Line

5			

Barber County

Location Rig up

Drilling and Remarks:

Spig 5412
Spig Sol. 5426
Ar 5611

RECORD

Cased in., ft.Sand Gas Oil Total Depth 5636

PRODUCTION

1st 24 hrs. Nat. 1st 24 hrs. after shot Gas Cu. Ft.Dry Hole Abandoned

Date

NOV 1 9 1947 19 S. J. LEWIS Scout

Yumi

Misc. Small Maps	☒
Cards	☒
Tracing	☒
France Map	☒
Scarborough Map	☒
Pierce Map	☒
Geological Dept.	☐
Pierce Plat Book	☐