
Form 51—5M—9-28—27423

Map No. KANSAS Sec. 11 Twp. 35 R. 5 6 W

Well No. 1- Jelinek Farm

Chas. R. Veal etal Company

NORTH

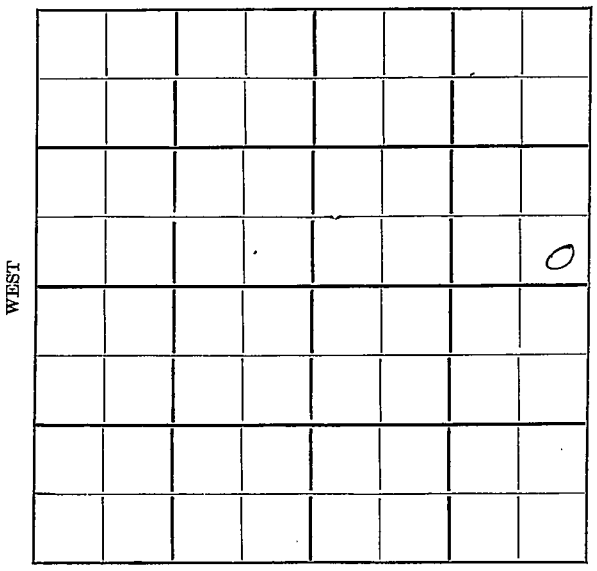

Location

Drilling Remarks

Rig Up

Drilling Remarks

RECORD

Cased ..... in. ..... ft.

Sand

Gas

Oil

Total Depth

PRODUCTION

1st 24 hrs. Nat.

1st 24 hrs. after shot

Gas ..... cu. ft.

Dry Hole

Abandoned

Form 252A—5M—5-28—Mid-West

Map No.....Sec.....Twp.....R.....

Well No.....Farm


.....Company

.....Ft. from N. Line

.....Ft. from S. Line

.....Ft. from E. Line

.....Ft. from W. Line

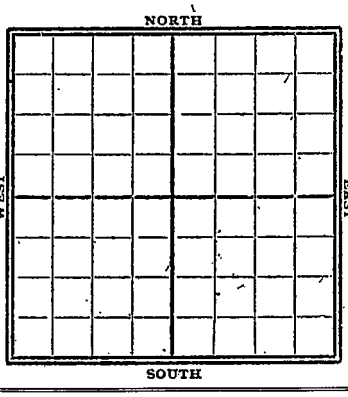

1928

Date	REPORT
	Gypsy Records
10/9	dry at 3810' Cmd TD 3828'

FORM 26 250 BKS. 4-28 WESTERN


MAP NO. _____ SEC. 11 TWP. 35S R. Lew

WELL NO. 1 Selmer

Ohio R. Pearl et al COMPANY

_____ CONTRACTOR

SECTION PLAT

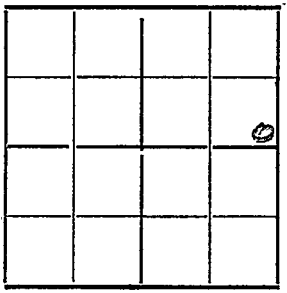

_____ FT. FROM N. LINE

_____ FT. FROM S. LINE

_____ FT. FROM E. LINE

_____ FT. FROM W. LINE

LOCATION _____

RIG UP _____

DRILLING AND REMARKS:

Dry at 3810
No Record
nothing in
file

RECORD

CASED _____ IN. _____ FT.

SAND _____

GAS _____

OIL _____

TOTAL DEPTH 3818

PRODUCTION

1ST 24 HRS. NAT. _____

1ST 24 HRS. AFTER SHOT _____

GAS _____ CU. FT.

DRY HOLE ✓

ABANDONED ✓

DATE

10/9 192 8 _____ SCOUT