

Section 11 Township 35 Range 1 W

Well No. # 1 Crow

Company Adair & Lee Phillips

NORTH

0							

WEST

EAST

SOUTH

Sumner

KANSAS

SEC.	TWP.	R.
11	35	1 W

WELL NO.

1 Crow

FARM

COMPANY

Adair & Lee Phillips

CONTRACTOR

Co. tools

Semi-Wildcat


330 Ft. from N. Line

' Ft. from S. Line

' Ft. from E. Line

330 Ft. from W. Line

NW NW NW

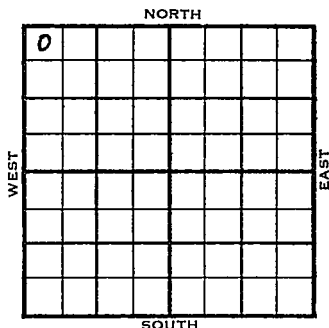

1955

ELEVATION

1087'

REPORT

1/26

MIR

2/16

Spud 1-26-55 D & A TD 4231
 8" @ 391 Stal. 2769 Layton 3163'
 Oswego 3524 KC 3350' Miss 3876
 DST 3880-3900 open 1½ hr. rec 1500'
 gas, 210' G & WCM 1000#
 DST 3876-88 open 1½ hr, 2300' gas,
 150' GCM 1000# Kh. 4154'
 Chattanooga 4204' Simp. 4223'
 DST 4214-26 open 1½ hr rec 60' WM
 1660#
 DST 4208-31 open 1½ hr. rec 360' SMSW
 1600# TD 4231' D & A

ABANDONED

County Sumner State KansasSec. 11 (Blk. Twp.) 35 (Sur. Rge.) 1W Map No.Operator Adair & Lee PhillipsWell No. 1 Farm CrowElev. Location NW NW NW

0							

FIRST REPORT

330 Ft. From N Line NW330 Ft. From W Line Quarter1st. Report JAN 26 1955

Completion

Remarks

Spudding Date

Drlg. Data Semi WildcatM I R


FABEN GILSTRAE

County Summer State Kansas
 Sec. 11 (Blk.) 35 (Sur.) 1W Map No.

Operator Adair & Lee Phillips

Well No. 1 Farm Crow

Elev. 1087 Location NW NW NW

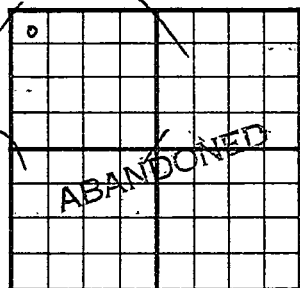

330 Ft. From N Line NW

330 Ft. From W Line Quarter

1st. Report

Completion FEB 16 1955

Remarks Semi Wildcat

Co. tools

Spudding Date 1-26-55

Drlg. Data D & A TD 4231

8" @ 391 Stal. 2769 Layton 3163

Oswego 3524 KC 3350 Miss. 3876

DST 3880-3900 open $1\frac{1}{2}$ hr. Rec. 1500'

gas 210' g & wcm 1000# DST 3876-88

open $1\frac{1}{2}$ hr 2300' gas 150' gcm 1000#

Kh. 4154 Chattanooga 4204 Simp. 4223

DST 4214-26 open $1\frac{1}{2}$ hr. Rec. 60' wm

1660# DST 4208-31 open $1\frac{1}{2}$ hr.

Rec. 360' smsw 1600# TD 4231

D & A

FABEN GILSTRAP