

WELL COMPLETION REPORT AND DRILLER'S LOG

S. 1 T. 35 R. 12 NE W
Loc. 150' NE of C NW SE
County Barber

API No. 15 — 007 — 21,252
County Number

Operator
ROBINSON OIL COMPANY

Address
737 R. H. Garvey Building, Wichita, KS 67202


Well No. 4 Lease Name MOLZ "B"

Footage Location
2086 feet from (N) (S) line 1874 feet from (E) (W) line

Principal Contractor SWEETMAN DRILLING, INC. Geologist Bob McCann

Spud Date 8/20/81 Date Completed 10/21/81 Total Depth 4898 P.B.T.D. 4838

Directional Deviation None Oil and/or Gas Purchaser Panhandle Eastern

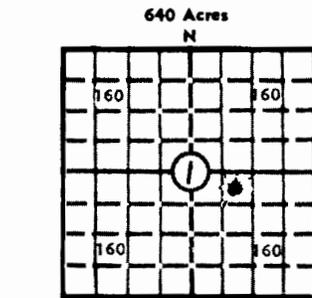

Elev.: Gr. 1405
DF 1411 KB 1415

CASING RECORD

Report of all strings set — surface, intermediate, production, etc.

Purpose of string	Size hole drilled	Size casing set (in O.D.)	Weight lbs/ft.	Setting depth	Type cement	Sacks	Type and percent additives
SURFACE	15"	10-3/4"	40#	276'	COMMON	250	2% Gel 3% CC
PRODUCTION	7-7/8"	4-1/2"	10.5#	4885'	COMMON	150	5% Salt

LINER RECORD

PERFORATION RECORD

Top, ft.	Bottom, ft.	Sacks cement	Shots per ft.	Size & type	Depth interval
	N/A		2	Jet	4806-4816

Size	Setting depth	Packer set at
2-3/8"	4814	None

ACID, FRACTURE, SHOT, CEMENT SQUEEZE RECORD

Amount and kind of material used	Depth interval treated
Frac w/22,500# 20-40 sand and 16,500# 10-20 sand in 21,000 gallons gelled 2% KCL water	4806-4816
500 gal. 15% MCA acid	

INITIAL PRODUCTION

Date of first production	Producing method (flowing, pumping, gas lift, etc.)
11/21/81	Pumping

RATE OF PRODUCTION PER 24 HOURS	Oil	Gas	Water	Gas-oil ratio
	5 bbls.	52 MCF	80 bbls.	10,400 CFPB

Disposition of gas (vented, used on lease or sold)	Producing interval(s)
Sold	4806-4816

INSTRUCTIONS: As provided in KCC Rule 82-2-125, within 90 days after completion of a well, one completed copy of this Drillers Log shall be transmitted to the State Geological Survey of Kansas, 4150 Monroe Street, Wichita, Kansas 67209. Copies of this form are available from the Conservation Division, State Corporation Commission, 245 No. Water, Wichita, Kansas 67202. Phone AC 316-522-2206. If confidential custody is desired, please note Rule 82-2-125. Drillers Logs will be on open file in the Oil and Gas Division, State Geological Survey of Kansas, Lawrence, Kansas 66044.

Operator ROBINSON OIL COMPANY

DESIGNATE TYPE OF COMP.: OIL, GAS, DRY HOLE, SWDW, ETC.:

Well No. 4 Lease Name Molz "B"

S 1 T 35 R 12 E 150' NE C NW SE

OIL

WELL LOG

Show all important zones of porosity and contents thereof; cored intervals, and all drill-stem tests, including depth interval tested, cushion used, time tool open, flowing and shut-in pressures, and recoveries.

SHOW GEOLOGICAL MARKERS, LOGS RUN, OR OTHER DESCRIPTIVE INFORMATION.

FORMATION DESCRIPTION, CONTENTS, ETC.	TOP	BOTTOM	NAME	DEPTH
DST. #1 4790-4830 (Mississippian) Open 30" (60") 60" (90") Strong blow, Rec. 200' gassey oil ISIBHP 1821 psi FSIBHP 1695 psi IFPS 385#-551# FFPS 260#-385#			Elgin Heebner Kansas City B/Kansas City Cherokee Mississippian RTD	3635 3815 4369 4602 4742 4796 4898
Red Bed & Shale Lime & Shale Total Depth	0 1526 4898	1526 4898		

USE ADDITIONAL SHEETS, IF NECESSARY, TO COMPLETE WELL RECORD.

Date Received

Dale M. Robinson

Signature

Owner

Title

January 15, 1982

Date

82-15-11

WELL LOG
MOLZ B #4
150' NE of C NWSE 1-35S-12W
Barber County, Kansas

Name of Operator: Robinson Oil Co.
300 West Douglas
Wichita, Kansas 67208

Date Completed: August 29, 1981

<u>FROM</u>	<u>TO</u>	
0	1526	Red Bed and Shale
1526	4898	Lime and Shale
4898		Total Depth

STATE OF KANSAS

COUNTY OF BARTON cc

Gary L. Hawk, Secretary of Sweetman Drilling, Inc., being first duly sworn on oath says: That I have knowledge of the facts, statements and matters herein contained and the log of the above described well as filed and that the same are true and correct.


Gary L. Hawk

Subscribed and sworn before me this 4th day of September, 1981.


Notary Public Barton County

My Commission Expires 6-12-84