

8-35-12W

KANSAS
State Geological Survey
WICHITA, BRANCH

**WELL COMPLETION REPORT AND
DRILLER'S LOG**


API No. 15 — 007 — 21,155
County Number

S. 8 T. 35S R. 12W E W

Loc. NW NE SE

County Barber

640 Acres
N

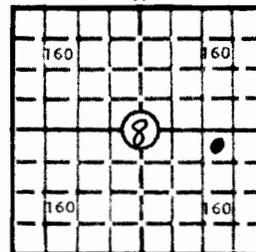

Locate well correctly

Elev.: Gr. 1421

DF KB 1434

Operator
Beren Corporation

Address
970 Fourth Financial Center, Wichita, Kansas 67202

Well No. 1 Lease Name McNALLY

Footage Location
feet from (N) (S) line feet from (E) (W) line

Principal Contractor BEREDCO, Inc. Geologist Bob Lewellyn

Spud Date 4/20/81 Date Completed 5/2/81 Total Depth 4879 P.B.T.D.

Directional Deviation Oil and/or Gas Purchaser

CASING RECORD

Report of all strings set — surface, intermediate, production, etc.

Purpose of string	Size hole drilled	Size casing set (in O.D.)	Weight lbs/ft.	Setting depth	Type cement	Sacks	Type and percent additives
Surface	12 1/4	8-5/8	20#	408	60-40 pozmix	300	2% gel, 3% CC
Production		5 1/2	14#	4877	60-40 pozmix	250	10% salt, 10# gi/ SX, 3/4 of 1% CFR-2

LINER RECORD

PERFORATION RECORD

Top, ft.	Bottom, ft.	Sacks cement	Shots per ft.	Size & type	Depth interval

Size	Setting depth	Packer set at

ACID, FRACTURE, SHOT, CEMENT SQUEEZE RECORD

Amount and kind of material used	Depth interval treated

INITIAL PRODUCTION

Date of first production Producing method (flowing, pumping, gas lift, etc.)

RATE OF PRODUCTION PER 24 HOURS	Oil	Gas	Water	Gas-oil ratio
	bbls.	MCF	bbls.	CFPB

Disposition of gas (vented, used on lease or sold) Producing interval(s)

INSTRUCTIONS: As provided in KCC Rule 82-2-125, within 90 days after completion of a well, one completed copy of this Drillers Log shall be transmitted to the State Geological Survey of Kansas, 4150 Monroe Street, Wichita, Kansas 67209. Copies of this form are available from the Conservation Division, State Corporation Commission, 245 No. Water, Wichita, Kansas 67202. Phone AC 316-522-2206. If confidential custody is desired, please note Rule 82-2-125. Drillers Logs will be on open file in the Oil and Gas Division, State Geological Survey of Kansas, Lawrence, Kansas 66044.

Operator

Beren Corporation

DESIGNATE TYPE OF COMP.: OIL, GAS, DRY HOLE, SWDW, ETC.:

Well No.

1

Lease Name

McNALLY

Oil

S 8 T 35S R 12W^E_W

WELL LOG

Show all important zones of porosity and contents thereof; cored intervals, and all drill-stem tests, including depth interval tested, cushion used, time tool open, flowing and shut-in pressures, and recoveries.

SHOW GEOLOGICAL MARKERS, LOGS RUN, OR OTHER DESCRIPTIVE INFORMATION.

FORMATION DESCRIPTION, CONTENTS, ETC.	TOP	BOTTOM	NAME	DEPTH
Sand and redbed	0	260		
Redbed	260	408		
Redbed and shale	408	1360		
Shale and lime	1360	4514		
Lime	4514	4660		
Lime and shale	4660	4879		
RTD	4879			

USE ADDITIONAL SHEETS, IF NECESSARY, TO COMPLETE WELL RECORD.

Date Received

Don Beauchamp

Signature

Don Beauchamp - Geologist

Title

June 11, 1981

Date

DRILLERS LOG

8-35-12W

MC NALLY #1
Barber County
C/NW NE SE
Sec. 8-35S-12W

SEP

Company: Beren Corporation

Contractor: BEREDCO INC.

Comm: 4/20/81

Comp.: 5/2/81

Casing: 8 5/8", 20# set at 408' with 300 sacks pozmix, 2% gel, 3% CC, 60-40
5 1/2", 14# set at 4877' with 250 sacks pozmix 10% salt, 2% gel,
10% gilsonite per sack, 3/4 of 1% CRF-2.

<u>FORMATION</u>	<u>FROM</u>	<u>TO</u>
Sand & RB	0'	260'
RB	260'	408'
RB & Shale	408'	1360'
Shale & Lime	1360'	4514'
Lime	4514'	4660'
Lime & Shale	4660'	4879'

Rotary total depth - 4879'

STATE OF KANSAS

ss:


COUNTY OF SEDGWICK

RECEIVED
STATE CORPORATION COMMISSION

I certify that this is a true and correct copy of the above logs as shown by the drilling reports. MAY 18 1981

CONSERVATION DIVISION
Wichita, Kansas

BEREDCO

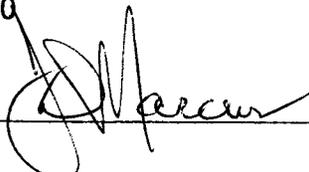

Subscribed and sworn to before me this 13th day of May, 1981.



