

KANSAS


Stevens

Section 12 Township 35 Range 39WWell No. 1 ReynoldsCompany Panhandle Eastern

Hugoton

NORTH

WEST

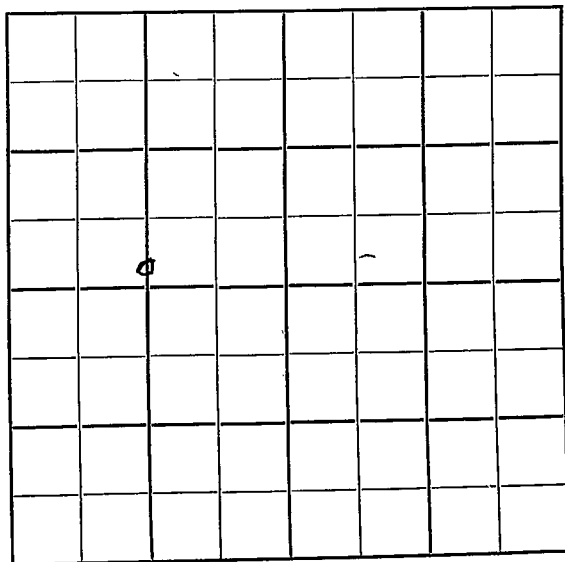

EAST

SOUTH

KANSAS

Stevens

Sec. 12 Twp. 35 R. 39W

Well No. #1 Reynolds Farm

Panhandle Eastern Company

2340'


Ft. from N. Line

Ft. from S. Line

Ft. from E. Line

1320'

Ft. from W. Line

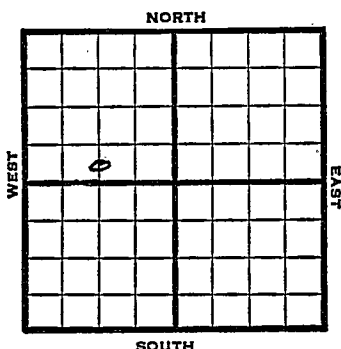

C S L NW

1949

Elev 322'

REPORT

4/13

Location

4/20

"

4/27

10" @ 614'

5/4

TD 2620'

7" @ 2615'

5/10

TD 2861'

254' of 5" Perf liner @ 2841

5/18

"

5/25

"

6/1

"

6/7

"

6/15

"

6/21

"

6/28

"

7/6

"

7/12

"

7/20

"

7/27

"

8/3

"

8/10

"

8/17

"

8/24

"

8/31

"

9/7

"

9/14

"

OVER

1949

9/21

TD 2861'

7" @ 2615

254' of 5" Perf Liner @ 2861'

11000 acid

16,870,000 Gas

352# R Pr.

Comp

COMPLETED

Map No. _____ Sec. 12 Twp. 35 R. 39W


Well No. 1 Reynolds

Panhandle Eastern Company

FIRST REPORT Contractor

C S L NW

SECTION PLAT

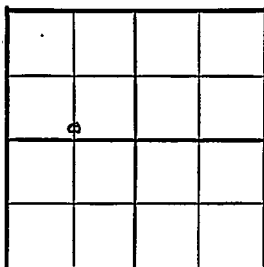

2340 Ft. from N. Line

_____ Ft. from S. Line

_____ Ft. from E. Line

1320 Ft. from W. Line

Stevens County

Location X

Rig up _____

Drilling and Remarks:

RECORD

Cased _____ in., _____ ft.

Sand _____

Gas _____

Oil _____

Total Depth _____

PRODUCTION

1st 24 hrs. Nat. _____

1st 24 hrs. after shot _____

Gas _____ Cu. Ft.

Dry Hole _____

Abandoned _____

Date

APR 13 1949

19

S. J. LEWIS

Scout

Scout Cards	✓
Land Small Map	✓
Land Wall Map	✓
Tracings	✓
France 1 st p	✓
Pierce Map	✓
Misc.	

Map No. _____ Sec. 12 Twp. 35 R. 39W

Well No. 1 Reynolds

Panhandle Eastern Company

COMPLETE

Contractor

C S L NW


E. 1, 324
SECTION PLAT

2340 Ft. from N. Line

_____ Ft. from S. Line

_____ Ft. from E. Line

1320 Ft. from W. Line

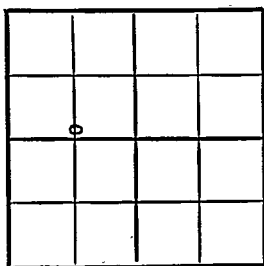

Stevens County

RECORD

Location _____

Rig up _____

Drilling and Remarks:

7" @ 2615

254' 15" Prof. Line

@ 2861

110000000

16,820,000 Gals

*352 * R/R*

Cased _____ in., _____ ft.

Sand _____

Gas _____

Oil _____

Total Depth 2861

PRODUCTION

1st 24 hrs. Nat. _____

1st 24 hrs. after shot _____

Gas _____ Cu. Ft.

Dry Hole _____

Abandoned _____

Date

SEP 21 1949 19

S. J. LEWIS Scout

Scout Cards

Land Small Map

Land Wall Map

Tracings

France Map

Pierce Map

Misc.