

Stevens


FORM 51 IOM 12-46 PETROL

KANSAS

Section 12 Township 35 Range 36W

Well No. 1 Peck

Company Northern Natural Gas

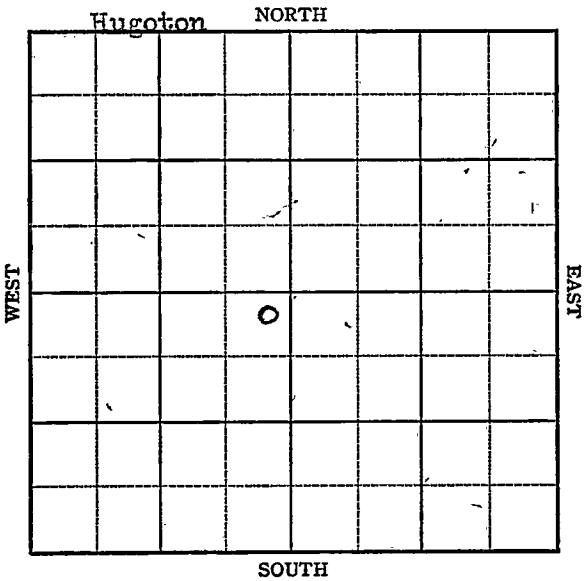

Sec. 12 Twp. 35 R. 36-W

Well No. #1 Peck Farm


Northern Natural Gas Company
Hugoton Pool

100 Ft. from N. Line

 Ft. from S. Line

100 Ft. from E. Line

 Ft. from W. Line

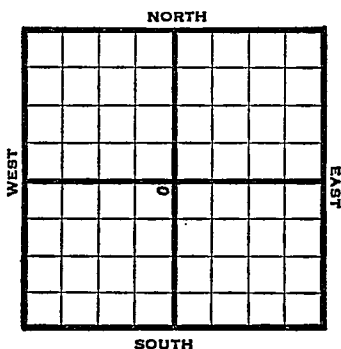

NE SW

1947 Elev. 3028' REPORT

6/11 Location

6/17 10" @ 704'
Drlg. 2661'

6/24 TD 2670
6" @ 2665'
RUST

7/1 16000 acid

7/8 "

7/16 "

7/22 "

7/30 7" @ 2665'
167' of 5" perf. liner @ 2825'
16000 Acid
21,109,000 Gas
427# R. Pr.
TD 2825'

COMPLETED

Map No. _____ Sec. 12 Twp. 35 R. 36WWell No. 1 Peck_____
Northern Natural Gas Company

FIRST REPORT

Contractor

NE SW

SECTION PLAT

100 Ft. from N. Line_____
Ft. from S. Line100 Ft. from E. Line_____
Ft. from W. Line_____
Stevens CountyLocation X

Rig up _____

Drilling and Remarks:

RECORD

~~Cased~~ _____ in., _____ ft.~~Sand~~ _____~~Gas~~ _____

Oil _____

Total Depth _____

PRODUCTION

1st 24 hrs. Nat. _____

1st 24 hrs. after shot _____

Gas _____ Cu. Ft.

Dry Hole _____

Abandoned _____

Date

JUN 1 1 1947 19S. J. LEWIS Scout

Map No. 0 Sec. 12 Twp. 35 R. 36W

Well No. 1 Peck

Northern Natural Gas Company

COMPLETE

Contractor

NE SW

E1.3018
SECTION PLAT

	Δ		

100 Ft. from N. Line

 Ft. from S. Line

100 Ft. from E. Line

 Ft. from W. Line

Stevens County

Location

Rig up

Drilling and Remarks:

7' @ 2665

167' of 5" Payline

@ 2825

16000 acft

21,109,000 gal

*427 * R. A.*

RECORD

Cased in., ft.

Sand

Gas

Oil

Total Depth *2725*

PRODUCTION

1st 24 hrs. Nat.

1st 24 hrs. after shot

Gas Cu. Ft.

Dry Hole

Abandoned

Date

JUL 30 1947

19

S. J. LEWIS

Scout