

Seward

KANSAS  
34W

Section 12 Township 35 Range 34W

Well No. 1 Dunlap

Company Panhandle Eastern

NORTH

|  |  |   |  |  |  |  |  |
|--|--|---|--|--|--|--|--|
|  |  |   |  |  |  |  |  |
|  |  |   |  |  |  |  |  |
|  |  | 0 |  |  |  |  |  |
|  |  |   |  |  |  |  |  |
|  |  |   |  |  |  |  |  |
|  |  |   |  |  |  |  |  |
|  |  |   |  |  |  |  |  |
|  |  |   |  |  |  |  |  |

WEST

EAST

SOUTH

Sec. 12 Twp. 35 R. 34W

Well No. #1 Dunlap Farm

Panhandle Eastern Company

Contractor


1600 Ft. from N. Line

\_\_\_\_\_ Ft. from S. Line

\_\_\_\_\_ Ft. from E. Line

1700 Ft. from W. Line

NW SE NW

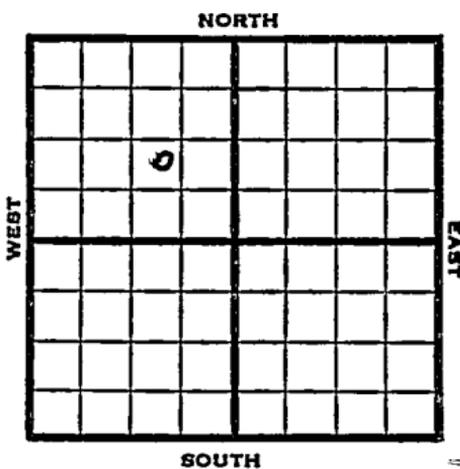

1952 Elev. 2888' REPORT

12/17 Spud 12-12-52  
10" @ 719'

12/25 " " "

1/1 NR

1/8 RTD 2651 6" @ 2645

1/22 DD TD 2752  
6" @ 2645, 10,000A

1/29 NR

2/5 "

2/12 NR

2/19 Ho1 2586, Her 2635, Up Kr 2696,  
Low K 2734

2/26 N.R.

3/12 NR

3/17 NR

3/26 NR

4/2 "

4/9 NR

4/16 "

4/23 "

**OVER**

1953  
4/29

Spud 12-12-52

Gas well TD 2752 10" @ 719

Hol. 2586 Her. 2635 Kri. 2696

TD 2651 6" @ 2645 DD 2752

10,000 A

Comp. 700,000 gas 351#

**COMPLETED**

County **Seward** State **Kansas**

Sec. **12** (Blk. **35**) (Sur. **34W**) Map No.

Operator **Panhandle Eastern**

Well No. **1** Farm **Dunlap**

Elev. Location **NW SE NW**

|  |   |  |  |  |  |
|--|---|--|--|--|--|
|  |   |  |  |  |  |
|  |   |  |  |  |  |
|  | 0 |  |  |  |  |
|  |   |  |  |  |  |
|  |   |  |  |  |  |
|  |   |  |  |  |  |
|  |   |  |  |  |  |
|  |   |  |  |  |  |

**1600** Ft. From **N** Line **NW**

**1700** Ft. From **W** Line **Quarter**

1st. Report **DEC 17 1952**

Completion

Remarks

Spudding Date **12-12-52**

Drlg. Data

**30" @ 719**

|                |       |
|----------------|-------|
| Scout Cards    | _____ |
| Land Small Map | _____ |
| Land Wall Map  | _____ |
| Tracings       | ..... |
| France Map     | _____ |
| Pierce Map     | _____ |
| Misc.          | ..... |

DEC 19 1952



MAY 6 1953

|                |    |
|----------------|----|
| Scout Cards    | MM |
| Land Small Map |    |
| Land Wall Map  | 5  |
| Tracings       |    |
| France Map     |    |
| Mercator Map   |    |
| Misc.          |    |

Orig. Date