
FORM 51 25M 8-50 WESTERN Seward KANSAS

Section 12 Township 35 Range 32 W

Well No. # 1 Wallace "B"

Company Huber Corp

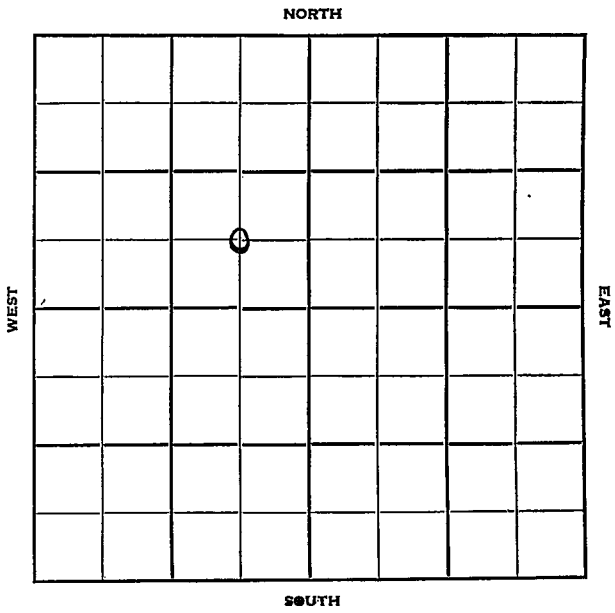

FORM 252-B
10M 11-50 PETROL

Seward KANSAS

Sec. 12 Twp. 35 R. 32 W

Well No. # 1 Wallace "B" Farm

Huber Corp. Company

Huber Contractor

Wildcat


____ Ft. from N. Line

660 Ft. from S. Line

660 Ft. from E. Line

____ Ft. from W. Line

C SE NW

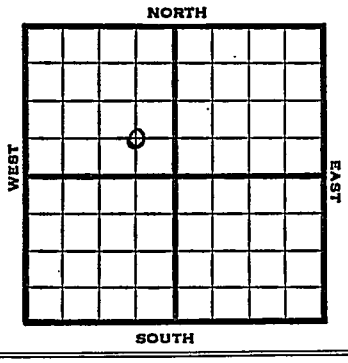

1951	Elev. 2741' REPORT --
	Miss. Test
12/12	MIR
1952	
1/30	Spud 12-13-51 D&A TD 6373 13" @ 600 9" @ 2400 Lans. 4475 Morrow sh 5944 Chester 6213 TD 6373 D&A
	ABANDONED

FORM 275 FOR SALE BY KANSAS BLUE PRINT CO.


County Seward State Kansas

Sec. 12 (Blk. Twp.) 35 (Sur. Rge.) 32W Map No.

Operator Huber Corp.

Well No. 1 Farm Wallace "B"

Elev. Location C SE NW

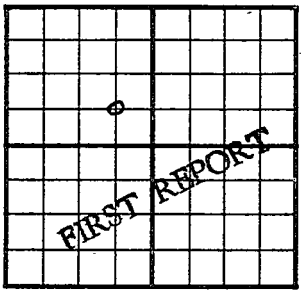

660 Ft. From S Line NW

660 Ft. From E Line Quarter

1st. Report DEC 1 2 1951

Completion

Remarks Miss. test

Huber - Contr.

Spudding Date

Drlg. Data Wildcat

M T R

J. E. TYRA

Scout Cards mm
Land Small Map
Land Wall Map 3
Tracings
France Map
Pierce Map
Misc.

DEC 27 1951

Dtlg. Data

FORM 275 FOR SALE BY KANSAS BLUE PRINT CO.


County Seward State Kansas

Sec. 12 (Blk. Twp.) 35 (Sur. Rge.) 32W Map No.

Operator Huber Corp.

Well No. 1 Farm Wallace "B"

Elev. 2741 Location C SE NW

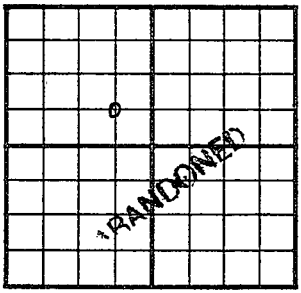

660 Ft. From S Line NW

660 Ft. From E Line Quarter

1st. Report

Completion JAN 2 0 1952

Remarks Wildcat

Huber - Contr.

Spudding Date 12-13-51

Drlg. Data D & A TD 6373

13" @ 600 9" @ 2400 Lans. 4475

Morrow sh. 5944 Chester 6213 TD 6373

D & A

J. G. McGEHEE

FEB 6 1932

Scout Cards
Land Small Map
Land Wall Map
Tracings
France Map
Pierce Map
Misc.

Drlg. Data