


Section 12 Township 35 Range 30 W

Well No. # 2-K Adams

Company Columbian Fuel

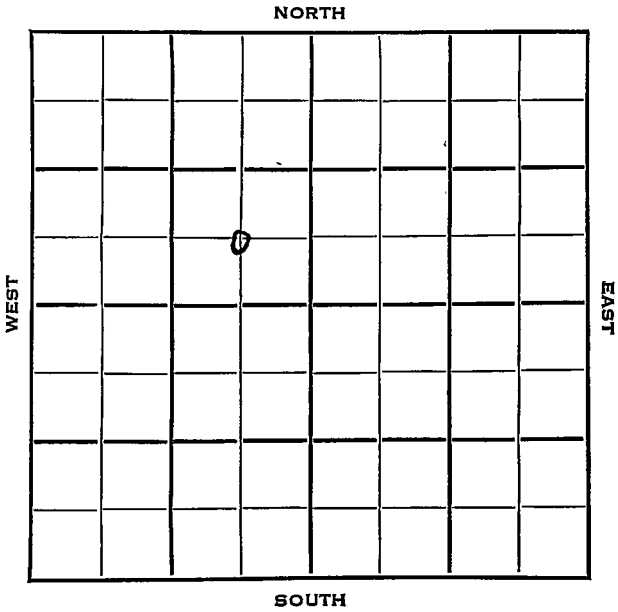

Sec. 12 Twp. 35 R. 30

Well No. #2-K Adams Farm

Columbian Fuel Company

Helmerich & Payne Contractor

E. Adams Ranch Pool NORTH


Ft. from N. Line

660 Ft. from S. Line

660 Ft. from E. Line

Ft. from W. Line

C SE NW

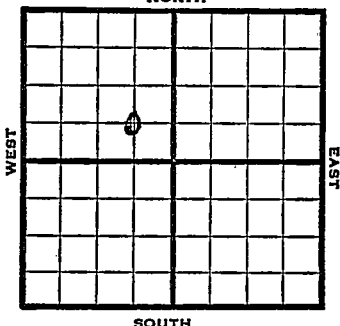

1953 Elev. 2444' REPORT

5/20 MIR
 5/28 13" @ 584
 Drlg. 1224'
 6/3 Schl 8" @ 2500
 Drlg. 2675'
 6/10 Drlg. 4510'
 Win 2600' Up Ft. 2660 Low Ft 2740
 6/24 RTD 5403'
 7/1 NR
 9/2 D & A
 9/16 Spud 5-22-53
 D & A
 TD 5930'
 13" @ 584'
 8" @ 2500'
 Win. 2600, Ft. Riley 2660, Lans 4475,
 DST 5250-5302 opn 1½ hr, rec 2560' gcs
 w. 1675#
 DST 5752-5815' opn 2 hr, 1½ mcfg
 120' gcm 1875#
 TD 5930'
 5" @ 5886'
 Morrow 5764, Chester 5857
 CO to 5868
 60/ 5851-62 500 A 6 gwph SP 5846

OVER

1953

Information brought forward.

9,16

162/ 5817-44 1000 A 62,000 gas
sq. 5817-44 CO to 5809' 36/ 5798-
5804 78/ 5769-82 580,000 gas
500 A 1000 A 500 A 119,000 gas
120/ 5782-5802
174,000 gas 2 gwph SP 5082
108/ 5048-66 2 bswph 130,000 gas
30/ 5001-06 3000' sw $1\frac{1}{4}$ hr,
30/ 4383-88 35 gwph
D & A

ABANDONED

MAY 22 1953

Scout Cards	PP
1 and Small Map	
and Wall Map	5
Tracings	
France Map	
France Map	
Misc.	


County Meade State Kansas

Sec. 12 (Blk. Twp.) 35 (Sur. Rge.) 30W Map No.

Operator Columbian Fuel

Well No. 2-K Farm Adams

Elev. 2444 Location C SE NW

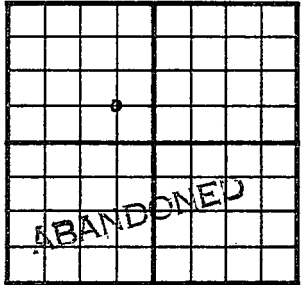

660 Ft. From S Line NW

660 Ft. From E Line Quarter

Ist. Report

Completion SEP 16 1953

Remarks E. Adams Ranch Pool

Helmerich & Payne - Contr

Spudding Date 5-22-53

Drlg. Data D & A TD 5930

13" @ 584 8" @ 2500 Win. 2600

Ft. Riley 2660 Lans. 4475 DST 5250-5302

open 1 1/2 hr. Rec. 2560' gcsw 1675#

DST 5752-5815 open 2 hr. 1 1/2 mcfg

120' gcm 1875# TD 5930 5" @ 5886

Morrow 5764 Chester 5857 CO to 5868

60/ 5851-62 500 A 6 gwph SP 5846

162/ 5817-44 1000 A 62,000 gas

sq. 5817-44 CO to 5809 36/ 5798-5804

78/ 5769-82 580,000 gas 500 A 1000 A

500 A 119,000 gas 120/ 5782-5802

174,000 gas 2 gwph SP 5082 108/ 5048-

66 2 bswph 130,000 gas 30/ 5001-06

3000' sw 1 1/4 hr. 30/ 4383-88. 35 gwph

D & A

J. G. McUTHEE

SEP 23 1953

Scout Cards
Land Small Map
Land Wall Map
Tracings
France Map
Pierce Map
Misc.

3

Orig. Date