


Morton

KANSAS

SECTION 13 TOWNSHIP 35S RANGE 43W

WELL NO. #1-13 Ruggles

COMPANY Panhandle Eastern

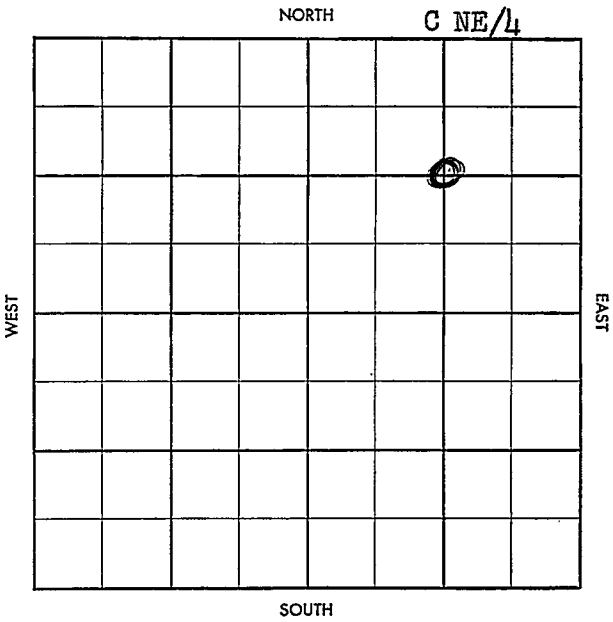

No. X Fee X
 No. X Fee X

County Morton Elev. _____
 Sec. 13 Twp. 35 Rge. 4 3W
 Company Panhandle Eastern
 Farm Name Ruggles No. 1-13

TOPS	DEPTH	LOG	DATUM
Anh.			
Tp.			
H.			
Tr.			
Dg.			
B.L.			
L.			
K.C.			
B.K.C.			
Ce.			
C.			
M.			
M.			
K.			
Mz.			
Mq.			
V.			
S.			
S.			
A.			
R.			
Pf.			
G.			
T.D.			

Loc. in Sec. _____


C NE/4

Geol. _____

Contr. _____

Ward tools

Pool _____

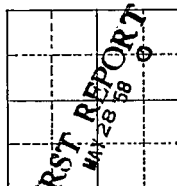GreenwoodDate Comm. 5-23-587" @drlg. 1800

~~Twp. Pool~~

~~Co. Face~~

S-513-B

County Morton Elev. 3617 or 3621
 Sec. 13 Twp. 35 Rge. 43W
 Company Panhandle Eastern
 Farm Name Ruggles No. 1-13

TOPS	DEPTH	LOG	DATUM
Anh. <u>W26</u>		<u>2698</u>	
Tr.		<u>2901</u>	
H. <u>Greenwood</u>		<u>3126</u>	
Tr.			
Dg.			
B.L.			
Tr.			
K.C.			
B.K.C.			
Ce.			
C.			
M.			
M.			
K.			
Mz.			
Mq.			
V.			
S.			
S.			
A.			
R.			
Pf.			
G.			
T.D. <u>3144</u>	<u>4124</u>		

Loc. in Sec. C NE/4

Geol. _____

Contr. _____

Ward tools

Pool _____

Greenwood

AUG 20 '58		
COMPLETE		

Date Comm. 5-23-58
 7" @ 695/200 drlg. 1800 JUN 3 '58
 2" 4" 3133/125 Log JUN 11 '58 20
3118 10/2968-73 16/2955-63
A ga 164 mcf + 59 wph 9/2942-46
12/2932-38 8/2924-28 8/2903-07
A ga 296 mcf + 70 g wph A ga
403 mcf + 120 for 20x10 36 hr
Shadow 819 mcf + 90 g wph JUN 18 '58 JUN 25 '58
ga 1.700 mcf + 70 g wph JUL 2 '58
 JUL 9 '58 JUL 18 '58 JUL 23 '58 JUL 30 '58 AUG 6 '58

AUG 13 1958

AUG 20 1958

State Del 795 MCF
RP 387 BTU 942
TP 2903 - 73
PB 3118

13-35-43W

CNE/4