


Map No. KANSAS Sec. 13 Twp. 35 R. 39^w

Well No. 1-Johnson Farm

Argus Gas Company

NORTH

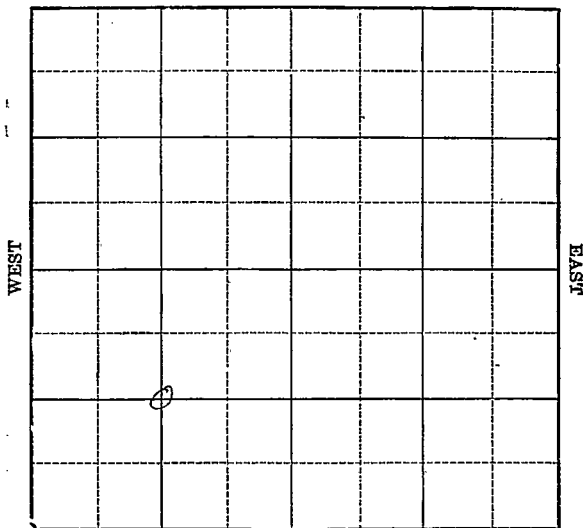

SOUTH

Location _____

Drilling Remarks _____

Rig Up _____

Drilling Remarks _____

RECORD

Cased _____ in. _____ ft.

Sand _____

Gas _____

Oil _____

Total Depth _____

PRODUCTION

1st 24 hrs. Nat. _____

1st 24 hrs. after shot _____

Gas _____ cu. ft. _____

Dry Hole _____


Abandoned _____

Map No. KANSAS Sec. 13 Twp. 35 R. 39^w

Well No. 1-Johnson Farm

Argus Gas Company

NORTH

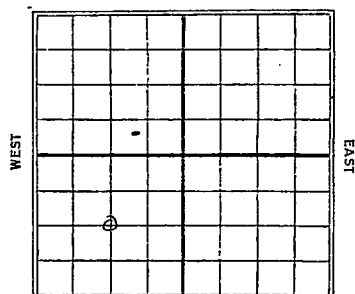

SOUTH

_____ Ft. from N. Line

1320 Ft. from S. Line

_____ Ft. from E. Line

1320 Ft. from W. Line

1930

Date

REPORT

6/18	Prod.
7/25	Rigs up.
7/2	
7/9	Drly 1725'
7/16	" 2256'
7/23	Rust 2490'
7/30	—
8/6	—
8/13	Drly. 2575'
8/20	Gas at 2655'
	Drly. 2760'
8/27	Gas 2655-2874
	1 1/8 M Gas

Map No. 25 **KANSAS** Sec. 13 Twp. 25 R. 29W

Well No. Johnson

Pruss Gas Company

J Contractor


SECTION PLAT

_____ Ft. from N. Line

1320 Ft. from S. Line

_____ Ft. from E. Line

1320 Ft. from W. Line

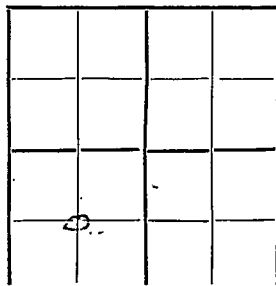

FIRST REPORTS

Location _____

Rig up _____

Drilling and Remarks:

ROG

RECORD

Cased _____ in., _____ ft.

Sand _____

Gas _____

Oil _____

Total Depth _____

PRODUCTION

1st 24 hrs. Nat. _____

1st 24 hrs. after shot _____

Gas _____ Cu. Ft.

Dry Hole _____

Abandoned _____

Date

JUN 18 1930

192

S. J. LEWIS

Scout

KANSAS

Map No. _____ Sec. 13 Twp. 35 R. 39^WWell No. 1Johnson
Argus Gas Co

Company

Contractor

COMPLETE

SECTION PLAT

_____ Ft. from N. Line

1320 Ft. from S. Line

_____ Ft. from E. Line

1320 Ft. from W. Line

Location _____

RECORD

Cased _____ in., _____ ft.

Sand _____

Gas 7655 - 2874

Oil _____

Total Depth 2874

Drilling and Remarks:

PRODUCTION

1st 24 hrs. Nat. _____

1st 24 hrs. after shot _____

Gas 1,152,000 Cu. Ft.

Dry Hole _____

Abandoned _____

Date

AUG 27 1930

19

CHAS. L. SHERWOOD

Scout