

Stevens


FORM 51 IOM 12-46 PETROL

KANSAS

Section 13 Township 35 Range 36W

Well No. 1 Angel

Company Northern Natural Gas

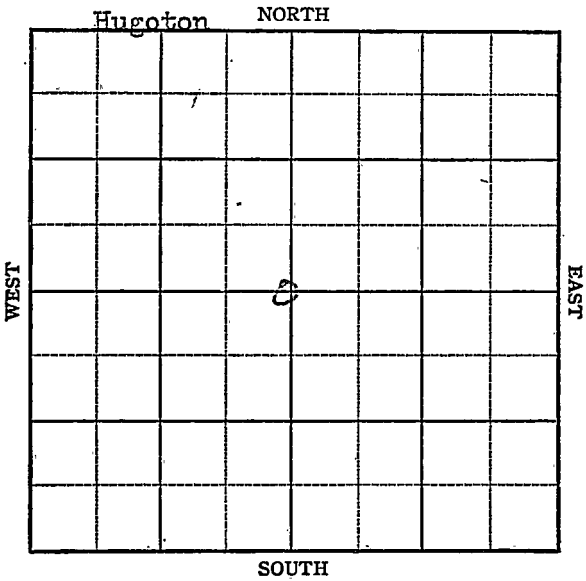

Sec. 13 Twp. 35 R. 36-W

Well No. #1 Angel Farm

Northern Natural Gas Company

Hugoton Pool


2640 Ft. from N. Line

 Ft. from S. Line

2640 Ft. from E. Line

 Ft. from W. Line

C Sec.

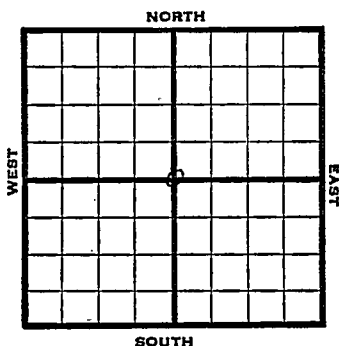

1947 Elev. 3019' REPORT

6/18 Location

6/24 10" @ 711'
Drlg. 2200'

7/1 Drlg 2735'
7" @ 2652'

7/8 TD 2818'
178' of 5" Perf. liner @ 2818'
16000 Acid.

7/16 7" @ 2652'
178' of 5" Perf liner @ 2818'
10,000 Acid
25,825,000 Gas
405 R. Pr.
T.d. 2818'

Complete

COMPLETED

Map No. _____ Sec. 13 Twp. 35 R. 36W

Well No. 1 Angel


Northern Natural Gas Company

FIRST REPORT

Contractor _____

C Sec. _____

SECTION PLAT

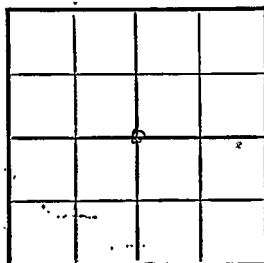

2640 Ft. from N. Line

_____ Ft. from S. Line

2640 Ft. from E. Line

_____ Ft. from W. Line

Stevens County

Location X

Rig up _____

Drilling and Remarks:

RECORD

Cased _____ in., _____ ft.

Sand _____

Gas _____

Oil _____

Total Depth _____

PRODUCTION

1st 24 hrs. Nat. _____

1st 24 hrs. after shot _____

Gas _____ Cu. Ft.

Dry Hole _____

Abandoned _____

Date

JUN 18 1947 19

S. J. LEWIS Scout

Map No. 0 Sec. 13 Twp. 35 R. 36W

Well No. 1 Angel

Northern Natural Gas Company

COMPLETE

Contractor

C Sec.

E 12019


SECTION PLAT

2640 Ft. from N. Line

 Ft. from S. Line

2640 Ft. from E. Line

 Ft. from W. Line

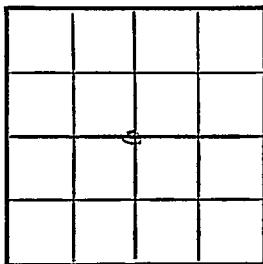

Stevens County

Location

Rig up

Drilling and Remarks:

7" @ 2652

175' x 15" Perf liner

@ 2818

16000 acid

25,825,000 Gas

*400 * D P*

RECORD

Cased in., ft.

Sand

Gas

Oil

Total Depth *2818*

PRODUCTION

1st 24 hrs. Nat.

1st 24 hrs. after shot

Gas Cu. Ft.

Dry Hole

Abandoned

Date

JUL 16 1947

19

S. J. LEWIS Scout