


Section 13 Township 35 Range 35-WWell No. #1 J J FarleyCompany Plains Natural Gas

NORTH

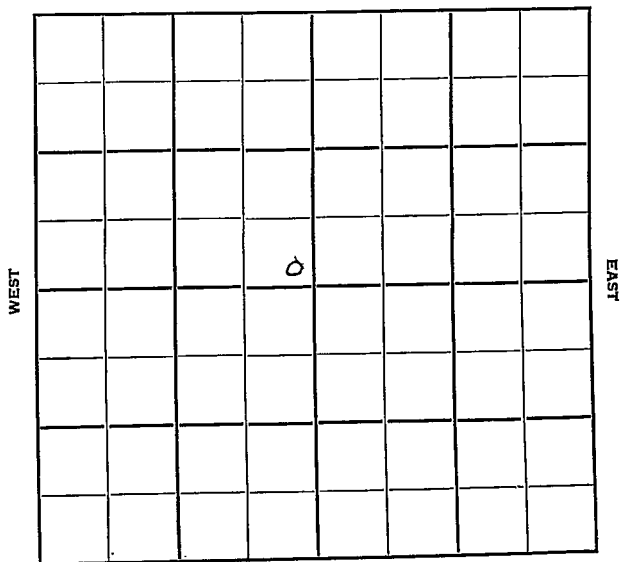

SOUTH

KANSAS

Stevens

Sec. 13 Twp. 35 R. 35-W

Well No. #1 J J Farley Farm ☒

Plains Natural Gas Company

Hugoton Contractor


 Ft. from N. Line

125 Ft. from S. Line

200 Ft. from E. Line

 Ft. from W. Line

SE NW

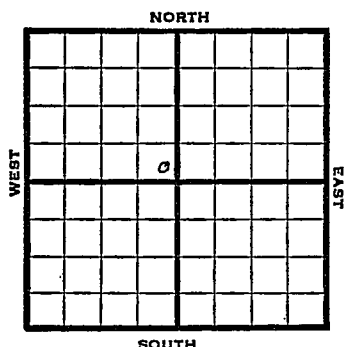

1950

Elev. 2960' REPORT

7/19

Location

8/20

Gas Well TD 2759'
10" @ 413' 7" @ 2738'
Hol. 2614' Her. 2679'
Krider 2710'
30/2732-37 30/2721-26
30/2714-19 26/2683-93
Comp. 769,000 gas
418#


COMPLETED

Kansas

Map No. _____ Sec. 13 Twp. 35 R. 35WWell No. 1 J. J. FarleyPlains Natural Gas Company_____
Contractor

SE NW

SECTION PLAT

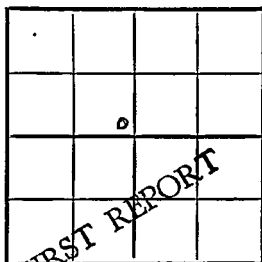Ft. from N. Line125 Ft. from S. Line200 Ft. from E. Line_____
Ft. from W. LineStevens CountyLocation X

Rig up _____

Drilling and Remarks:

RECORD

Cased _____ in., _____ ft.

Sand _____

Gas _____

Oil _____

Total Depth _____

PRODUCTION

1st 24 hrs. Nat. _____

1st 24 hrs. after shot _____

Gas _____ Cu. Ft.

Dry Hole _____

Abandoned _____

Date

JUL 19 1950J. E. TYRA19Scout

J. E. TYRA