


KANSAS

FORM 51 25M 3-49 PETROL

Section 13 Township 35 Range 33 W

Well No. 1 Warden

Company White Eagle Oil

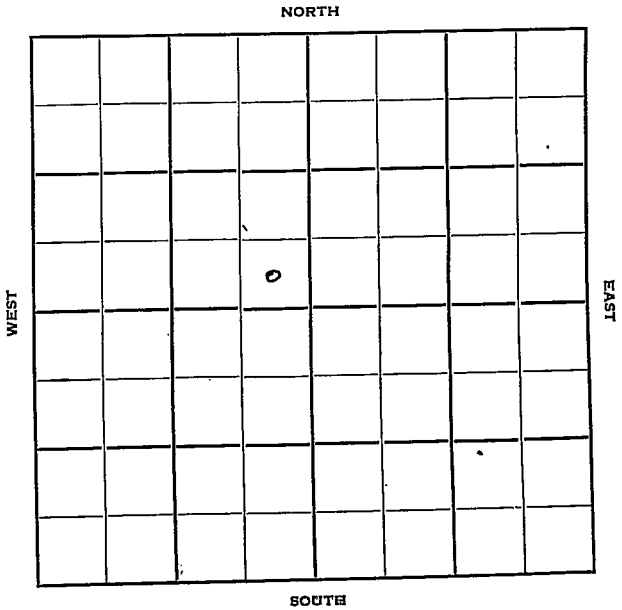

Seward

KANSAS

Sec. 13 Twp. 35 R. 33W ✓

Well No. #1 Warden Farm

White Eagle Oil Company

Contractor

Wildcat


 Ft. from N. Line

330' Ft. from S. Line

330' Ft. from E. Line

 Ft. from W. Line

SE SE NW

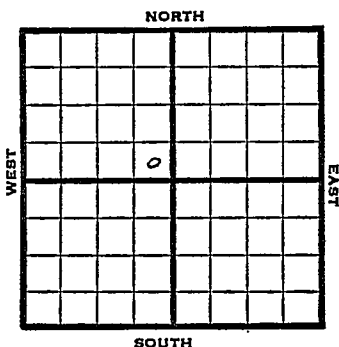

1950

Elev 2788

REPORT

5/17

Location

8/23

13" @ 603

Her 2615

Krider 2667

Win 2718

8" @ 2929

Morrow sand 6060-82

DST 6063-6128 opn 20 min rec 180' mud

Miss 6126-31

5½ @ 6063

TD 6131

Comp 6,792,000 gas

Completed

COMPLETED

Map No. _____ Sec. 13 Twp. 35 R. 33WWell No. 1 WardenWhite Eagle Oil Company

Contractor _____

SE SE NW

SECTION PLAT

_____ Ft. from N. Line

330 Ft. from S. Line330 Ft. from E. Line

_____ Ft. from W. Line

	0		
FIRST REPORT			

Seward

Location X

Rig up _____

Drilling and Remarks: _____

RECORD

Cased _____ in., _____ ft.

Sand _____

Gas _____

Oil _____

Total Depth _____

PRODUCTION

1st 24 hrs. Nat. _____

1st 24 hrs. after shot _____

Gas _____ Cu. Ft.


Dry Hole _____

Abandoned _____

Date

MAY 17 1950 19J. E. TYRA Scout

County Seward State Kansas
 Sec. 13 (Blk. 35) (Sur. 33W) (Twp. Map No.)
 Operator White Eagle Oil
 Well No. 1 Farm Warden
 Elev. 2788 Location SE SE NW

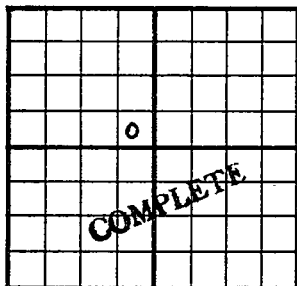

330 Ft. From S Line NW
330 Ft. From E Line Quarter
 1st. Report
 Completion AUG 23 1950
 Remarks
Wildcat
 Spudding Date

Drlg. Data Gas well TD 6131
13" @ 603 Her. 2615 Krider 2667
Win. 2718 8" @ 2929 Morrow sand 6060-82
DST 6063-6128 open 20 min. Rec. 180' mud
Miss. 6126-31 5½" @ 6063 TD 6131
Comp. 6,792,000 gas

J. E. TYRA