


Section 13 Township 35 Range 32 WWell No. # 1 Wallace (A)Company Huber Corp

NORTH

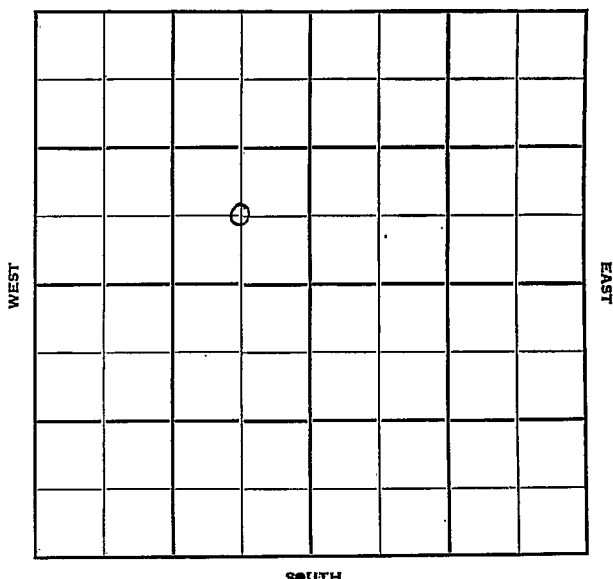

Sec. 13 Twp. 35 R. 32WWell No. #1 Wallace (A) Farm

Huber Corp. Company

Huber Contractor


Light Pool

Ft. from N. Line

660' Ft. from S. Line

660' Ft. from E. Line

Ft. from W. Line

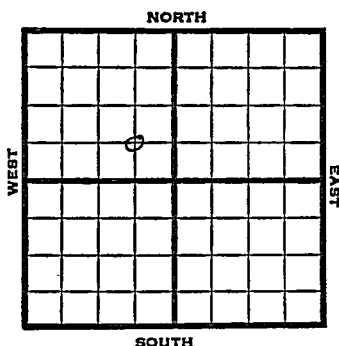

C SE NW

1951

Elev. 2753' REPORT

6/27

Location Morrow Sd Test

1952

1/16

Spud 7-10-51

D & A TD 8103' 13-3/8" @ 650

9-5/8" @ 2385' Miss 6206'

DST 6216-67 open 1 hr. rec 90' mud

DST 6255-6350 open 1 hr. rec 250' mud

DST 6454-99 open 1/2 hr. rec 15' mud

DST 6674-6717 open 1 hr. rec 15' mud

DST 6840-6923 open 2 hr, rec 3500' SW

DST 6976-7048 open 1 hr. rec 1350' SW

DST 7211-7304 open 1 hr, rec 10' mud

DST 7403-90 open 2 hr, gas in 32 min
rec 262' OCM, 180' MCODST 7495-7560 open 1 hr, rec 720' mud
120' SOCM.

DST 7718-70 open 1/2 hr. rec 430' mud

DST 7774-7814, open 45 min. rec mud

DST 7864-7935, rec 800' mud

DST 7935-66 open 1 hr, rec 2' mud

DST 8040 open 1 hr. rec 2340' SW

TD 8103' 5" @ 7597 CO to 7561'

72/4785-94

DST 7477-94 open 5 hr, 40 min.

S/3 1/2 BF 6 hr mostly oil, 1000 A

S/1 BFPH 50% oil, 2000 A S/20 BF

8 hr. 40% oil, dec. to 6-3/4 BF

8 hr. 40% oil. SP 7498 152/7499-

7519 3/4 BWPB & SSO 6000 A

OVER

1952

1/16

(Information continued)

S/21 BF 5 hr. CO to 7561

S/28 BF $4\frac{1}{2}$ hr. 20% oil. 80% SW

S/11 BW 4 BO 5 hr. PB 6440'

8/6437-38 3/6344-45 73/6349-59

1000 A Lans. 4462' Marm. 5417'

Morrow sh. 5964' Viola 7658'

Simp. 7884' Arb. 7964'

D & A

ABANDONED

County Seward State KansasSec. 13 (Blk. Twp.) 35 (Sur. Rge.) 32W Map No.Operator Huber Corp.Well No. 1 Farm Wallace (A)Elev. Location C SE NW

FIRST REPORT									

660 Ft. From S Line NW660 Ft. From E Line Quarter1st. Report JUN 27 1951

Completion

Remarks Morrow sd. test.

Spudding Date

Drig. Data Light Pool


Location

J. E. TYRA

49. 12 1951

Scout Cards	
Land Small Map	
Land Veli map	
Trains	
France Map	
Pierce Map	
Misc.	

County Seward State Kansas
 Sec. 13 (Blk.) 35 (Sur.) 32W Map No.
 Operator Huber Corp.
 Well No. 1 Farm Wallace "A"
 Elev. 2753 Location C SE NW

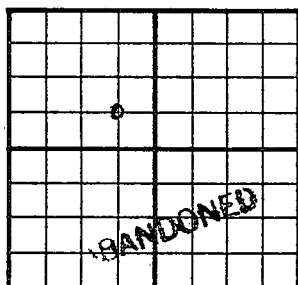

660 Ft. From S Line NW
660 Ft. From E Line Quarter
 Ist. Report
 Completion JAN 16 1952
 Remarks Light Pool
Huber - Contr.
 Spudding Date 7-10-51

Drlg. Data D & A TD 8103

13 3/8" @ 650 9 5/8" @ 2385

Miss. 6206 DST 6216-67 open 1 hr.

Rec. 90' mud DST 6255-6350 open 1 hr.

Rec. 250' mud DST 6454-99 open 1/2 hr.

Rec. 15' mud DST 6674-6717 open 1 hr.

Rec. 15' mud DST 6840-6923 open 2 hr.

Rec. 3500' sw DST 6976-7048 open 1 hr.

Rec. 1350' sw DST 7211-7304 open 1 hr.

Rec. 10' mud DST 7403-90 open 2 hr.

gas in 32 min. Rec. 262' ocm 180' mco

DST 7495-7560 open 1 hr. Rec. 720' mud

120' socm DST 7718-70 open 1/2 hr.

Rec. 430' mud DST 7774-7814 open 45 min.

Rec. mud DST 7864-7935 Rec. 800' mud

J. E. TYRA

JAN 23 1952

Scout Cards	mm
Land Small Map	
Land Wall Map	3
Tracings	
France Map	
Pierce Map	
Misc.	

D & A

Wicks 7658 Simp. 7884 Arb. 7964
Lans. 4462 Marm. 5417 Morrow Sh. 5964

1000 A

8/ 6437-38 3/ 6344-45 73/ 6349-59

80% SW S/ 11 bw 4 bo 5 hr. PB 6440.

CO to 7561 S/ 28 bf 4 1/2 hr. 20% oil.

3/4 bwph & SSO 6000 A - 1 S/ 21 bf 5 hr.

40% oil SP 7498 152/ 7499-7519

8 hr. 40% oil dec. to 6 3/4 bf 8 hr.

S/ 1 biph. 50% oil 2000 A S/ 20 bf

6 S/ 3 1/2 bf 6 hr. mostly oil 1000 A

72/ 4785-94 DST 7477-94 open 6 hr. 40% oil

TD 8103 5" @ 7597 CO to 7561 Land Wall Map

DST 8040 open 1 hr. Rec. 2340 Tracings

DST 7935-55 open 1 hr. Rec. 2140

Misc.

Drig. Date