


Section 13 Township 35 Range 31 W

Well No. # 1 Blucher

Company Huber Corp

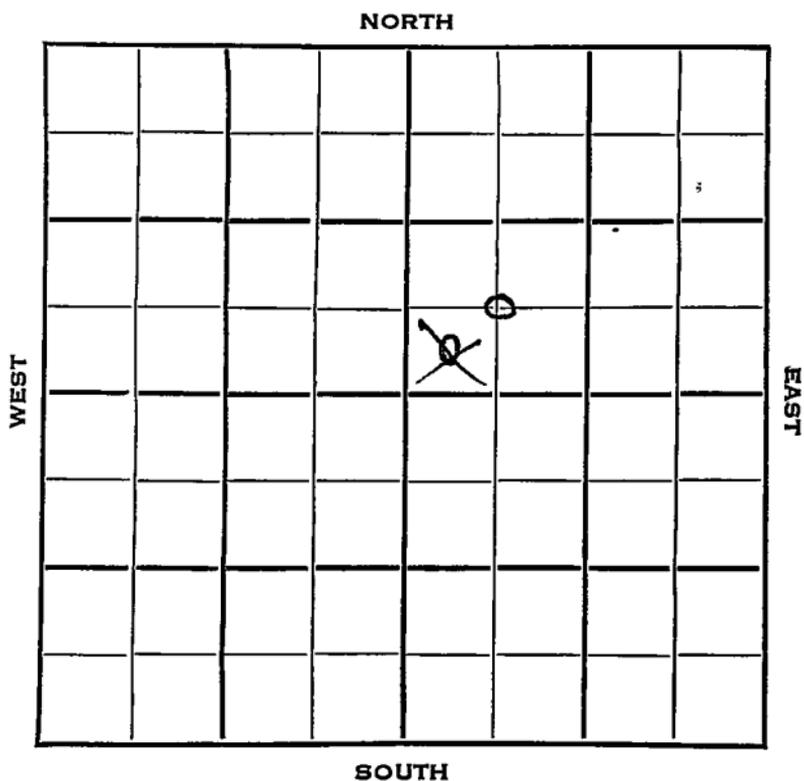

Sec. 13 Twp. 35 R. 31 W

Well No. # 1 Blucher Farm

Huber Corp. Company

Contractor

Wildcat


Ft. from N. Line

~~330~~ 660 Ft. from S. Line

Ft. from E. Line

~~330~~ 660 Ft. from W. Line

C  
~~SW~~ SW NE

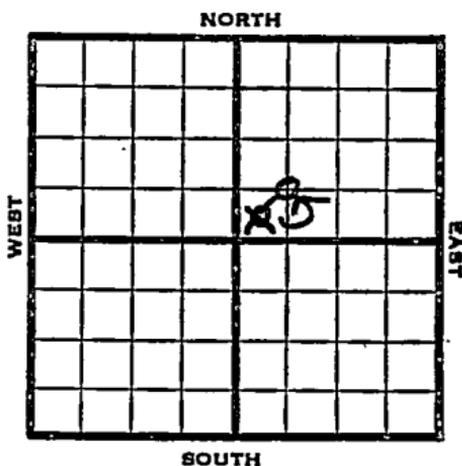

1953

Elev. 2679'

REPORT

Miss. Test

8/5

Location

8/12

RUR

8/19

13" @ 638'  
TD 2407'

8/26

Drlg. 3570'

9/2

N.R.

9/9

Drlg. 5624'

9/23

D & A

9/30

Spud 8-13-53

D & A

TD 6350'

13" @ 638'

9" @ 2406'

DST 5419'-78' opn 1 hr, rec 30' socm  
150#

DST 5482'-5501' opn 1 hr, rec 35' mud  
0#. Hol. 2610, Her. 2655, Morrow 5926

DST 5678'-86' opn 1 hr, rec 75' mud

DST 6098'-6220' failed.

DST 6142'-6230' opn 1 hr, rec 55' mud  
900#

TD 6350'

Kri. 2716, Win 2787 Tow. 2850, Ft.

OVER

1953

Information brought forward.

9/30 Riley 2919, Lans 4490, Marm 5402,  
Morrow 5895, Chester 5143 (?)  
D & A

No

**ABANDONED**

Map No. \_\_\_\_\_ Sec. 13 Twp. 35 R. 31W

Well No. 1 Blucher

Huber Corp. Company

**CORRECTION**

Contractor

~~C SWNE~~  
*correct*


**SECTION PLAT**

\_\_\_\_\_ Ft. from N. Line

660 Ft. from S. Line

\_\_\_\_\_ Ft. from E. Line

660 Ft. from W. Line

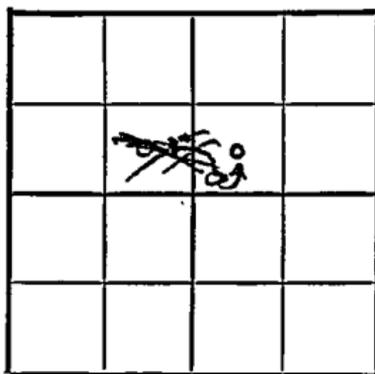

Seward County

Location \_\_\_\_\_

Rig up \_\_\_\_\_

Drilling and Remarks:

*Reported*

*SW SW NE*

**RECORD**

Cased \_\_\_\_\_ in., \_\_\_\_\_ ft.

Sand \_\_\_\_\_

Gas \_\_\_\_\_

Oil \_\_\_\_\_

Total Depth \_\_\_\_\_

**PRODUCTION**

1st 24 hrs. Nat. \_\_\_\_\_

1st 24 hrs. after shot \_\_\_\_\_

Gas \_\_\_\_\_ Cu. Ft.

Dry Hole \_\_\_\_\_

Abandoned \_\_\_\_\_

Date

AUG 19 1952

19

J. G. Mc...

Scout

Scout Cards *MTM*  
Land Staff Map.....  
Land Wall Map.....  
Trails.....  
Franchise Map *MB*  
Picnic Map.....  
Misc. ....

AUG 21 1953



Scout Cards	MM
Land Small Map	
Land Wall Map	33
Tracings	
France Map	
Pierce Map	
Misc.	

AUG 7 1953

Orig. Data



OCT 8 1959

Scout Cards	.....
Lat. & Small Maps	.....
Land Wall Map	.....
Tracings	.....
State & Map	.....
Map	.....
.....	.....

Orig. Data