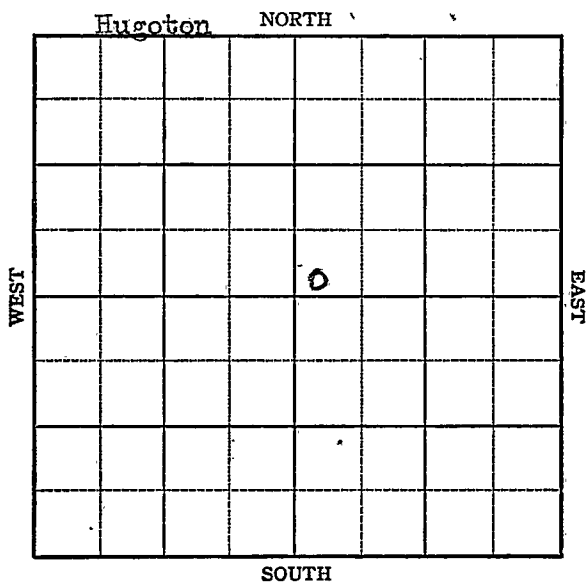


Stevens

KANSASSection 14 Township 35 Range 36WWell No. 2 PeckCompany Northern Natural Gas

KANSAS

Stevens county

Sec. 14 Twp. 35 R. 36W

Well No. 2 Peck Farm

Northern Natural Gas Company

Hugoton Pool

 Ft. from N. Line

100


 Ft. from S. Line

 Ft. from E. Line

100

 Ft. from W. Line

SW NE

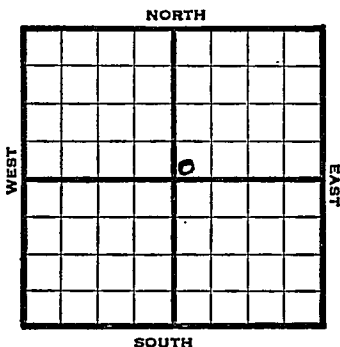

1947

REPORT

6/25

Location

7/1

Drlg 646'

7/8

10" @ 631'
TD 2675'
7" @ 2661'
RUST

7/16

"

7/22

TD 2675

7/29

TD 2790'
138' of 5" Perf @ 2790'

8/6

7" @ 2661'
138' of 5" Perf Liner @ 2790'
18000 acid.
29,997,000 Gas.
R. Pr. 421#
T.D. 2790'
Complete

COMPLETED

Map No. _____ Sec. 14 Twp. 35 R. 36W

Well No. 2 Peck

Northern Natural Gas Company

MAST REPORT Contractor

SW NE

SECTION PLAT

_____ Ft. from N. Line

100 Ft. from S. Line

_____ Ft. from E. Line

100 Ft. from W. Line

		o	
	.		

Stevens County

Location X

Rig up _____

Drilling and Remarks:

RECORD

Cased _____ in., _____ ft.

Sand _____

Gas _____

Oil _____

Total Depth _____

PRODUCTION

1st 24 hrs. Nat. _____

1st 24 hrs. after shot _____

Gas _____ Cu. Ft.

Dry Hole _____

Abandoned _____

Date

JUN 25 1947 '19

S. J. LEWIS Scout


Map No. 0 Sec. 14 Twp. 35 R. 36WWell No. 2 Peck

Northern Natural Gas Company

COMPLETE

Contractor

SW NE

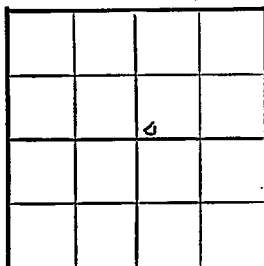E13011
SECTION PLAT Ft. from N. Line100 Ft. from S. Line Ft. from E. Line100 Ft. from W. Line

Stevens County

Location Rig up

Drilling and Remarks:

*7" @ 2661**135' of 5" Perf lined**@ 2790**18000 aced**29,887,000 Gas**421 #R 12*

RECORD

Cased in., ft.Sand Gas Oil Total Depth 2790

PRODUCTION

1st 24 hrs. Nat. 1st 24 hrs. after shot Gas Cu. Ft.Dry Hole Abandoned

Date

AUG 6 1947 19 S. J. LEWIS Scout