


Section 14 Township 35 Range 32 W

Well No. # 1 Feese

Company J. M. Huber

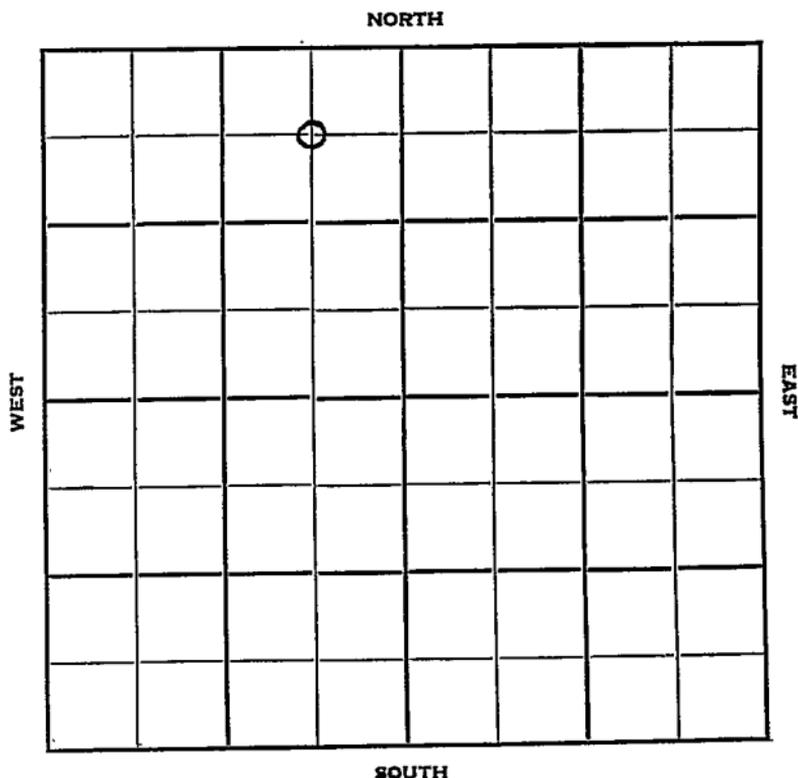

Sec. 14 Twp. 35 R. 32 W

Well No. # 1 Feese Farm

J. M. Huber Company

Contractor

Hugoton Pool


660 Ft. from N. Line

Ft. from S. Line

660 Ft. from E. Line

Ft. from W. Line

C NE NW

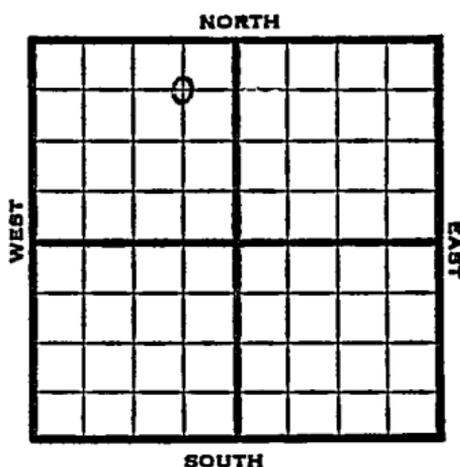

1951 Elev. 2743' REPORT

3/21
5/29

MIM
13" Casing set 615'
9" casing set 2392'
7" casing set 6126'
TD 6126'
Cleaned out to 6122'
Perf 150 shots 5943-68'
Tested 11,250,000 gas thru 3/4/68" choke
Tested 77,850,000 gas thru open flow
Shut In Pressure 1700#

6/6 Spud 3-24-51
Gas well TD 6126'
13" @ 615 9-5/8" @ 2392'
DST 5946-68' open 1/2 hr. gas in 2 min.
10' water, 20' dist. TD 6126'
7" @ 6126' CO to 6122'
150/5943-68 11,257,000 gas
Morrow sand 5942-64 13,813 MCFG
89 BO 2 BW
Comp. open flow/ 55,250,000 gas

COMPLETED


County **Seward** State **Kansas**

Sec. **14** (Blk. Twp.) **35** (Sur. Rge.) **32W** Map No.

Operator **J. M. Huber**

Well No. **1** Farm **Feese**

Elev. Location **G NE NW**

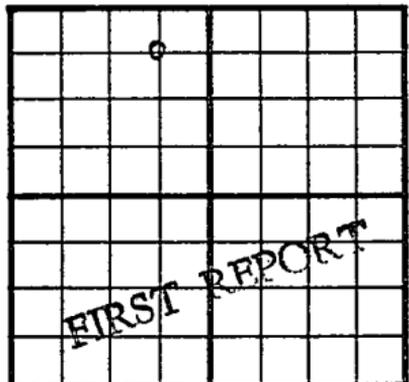

660 Ft. From **N** Line **NW**

660 Ft. From **E** Line **Quarter**

Ist. Report **MAR 21 1951**

Completion

Remarks

Spudding Date

Drilg. Data **Hugoton Pool**

M I M

J. E. TYRA

Scout Cards	<i>mm</i>	MAR 23 1951
Land Small Map		MAR 27 1951
Land Wall Map	<i>5</i>	
Tracings		
France Map		
Pierce Map		
Misc.		

Orig. Date


County Seward State Kansas

Sec. 14 (Blk. 35 (Sur. 32W (Twp.) Map. No.)

Operator J. M. Huber

Well No. 1 Farm Feese

Elev. 2743 Location C NE NW

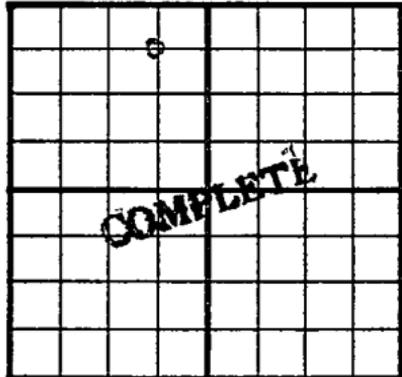

660 Ft. From N Line NW

660 Ft. From E Line Quarter

Ist. Report

Completion JUN 6 1951

Remarks Hugoton Pool

Spudding Date 3-24-51

Drlg. Data Gas well TD 6126

13" @ 615 9 5/8" @ 2392 DST 5946-68

open 1/2 hr. gas in 2 min. 10' water

20' dist. TD 6126 7" @ 6126 CO to 6122

150/ 5943-68 11,257,000 gas

Morrow sand 5942-64 13,813 mcfg 89 bo

2 bw Comp. open flow/ 55,250,000 gas

J. E. TYRA

Scout Cards	<i>2272</i>
Land Small Map
Land Wall Map	<i>3</i>
Tracings
France Map
Pierce Map
Misc

JUN 13 1951

Orig. Data