

KANSAS


Seward

FORM 51 5M PETROL

Section 14 Township 35 Range 31W

Well No. 1 Adams Ranch unit #1
~~1 Federal Land Bank~~

Company Stanolind

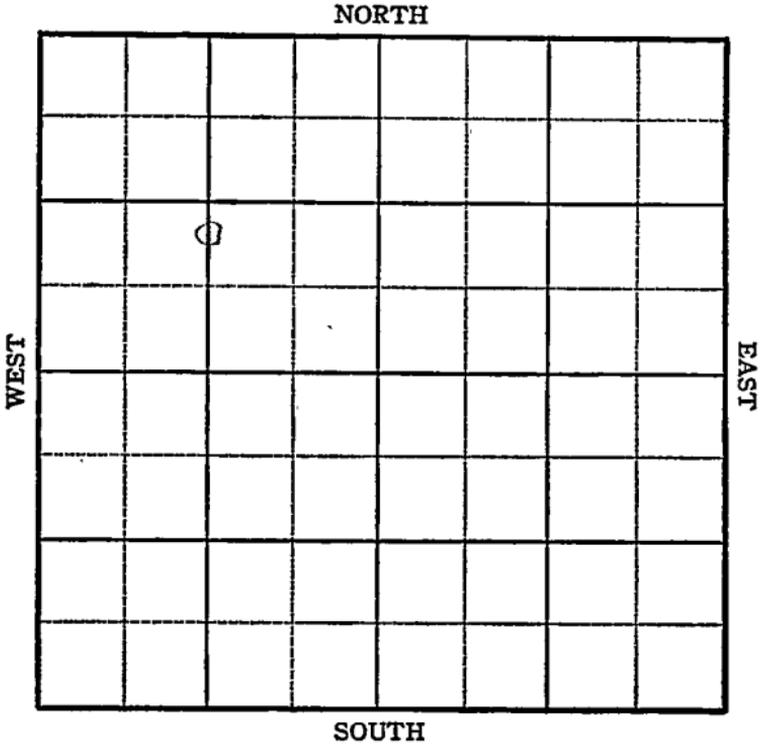


Sec. 14 Twp. 35 R. 31-W
Adams Ranch Unit #1
 Well No. #1 Federal Land Bank Farm _____
 Stanolind _____ Company

1800 Ft. from N. Line

_____ Ft. from S. Line

_____ Ft. from E. Line

1320 Ft. from W. Line

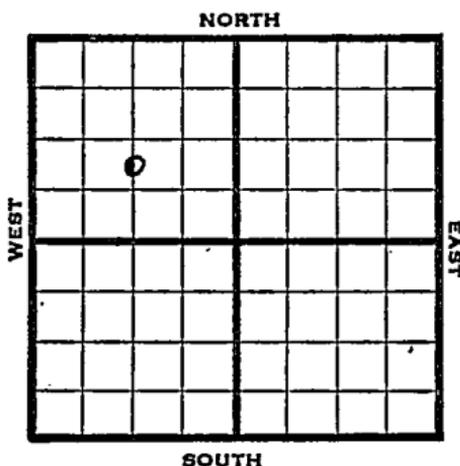

C N L S $\frac{1}{2}$ NW *El. 2699*

1945 Elev. 2699 REPORT

11/28 Location

12/5 RUR

12/12 13" @ 610 WOC

12/20 Anhy 1535' 8" - 2418' WOC.

12/29 Holenberg 2639-49'
 Herington 2698-2710'
 Drlg. 2772'

1946

1/10 Krider 2765' Winfield 2841'
 Drlg. 3958'

1/17 Drlg. 4763'

1/24 Drlg. 5318'

1/31 Drlg. 5708'

2/7 " "
 2/14 Miss 6196' Drlg. 6374'

2/21 Coring 6730'

2/28 T.D. 6800' 5" - ~~6145~~ 6165
 WOC.

3/7 " "

3/14 C.O. 6190'

3/21 " "

3/28 5" - 6165' (Corrected)
 56 shots 6150-64' no shows.

4/4 7000 acid.
 2 W per hr.
 315,000 Gas

4/10 5" @ 6145
 TD 6800'

ABANDONED

KANSAS Kansas Pool Name WildcatMap No. 10 Map Sec. 14 Twp. 35 R. 31WWell No. 1 Federal Land Bank

Stanolind


Company

FIRST REPORT

Contractor

C N L S $\frac{1}{2}$ NW

SECTION PLAT

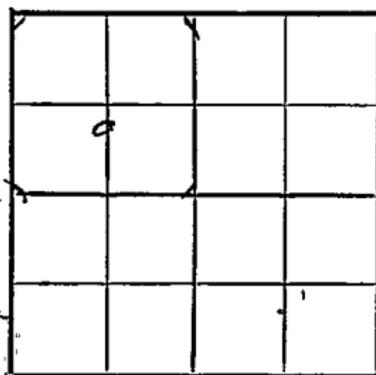1800 Ft. from N. Line Ft. from S. Line Ft. from E. Line1320 Ft. from W. Line

Seward County

Location XRig up

Drilling and Remarks:

RECORD

Cased in., ft.Sand Gas Oil Total Depth

PRODUCTION

1st 24 hrs. Nat. 1st 24 hrs. after shot Gas Cu. Ft.Dry Hole Abandoned

Date

NOV 28 1945

19

S. J. LEWIS

Scout

KANSAS

Kansas

Pool Name Wildcat

Map No. Domas Sec. 14 Twp. 35 R. 31W

Well No. 1 Adams Ranch Unit #1

Stanolind

Company

CORRECTION.

Contractor

C N L S $\frac{1}{2}$ NW


SECTION PLAT

1800 Ft. from N. Line

_____ Ft. from S. Line

_____ Ft. from E. Line

1320 Ft. from W. Line

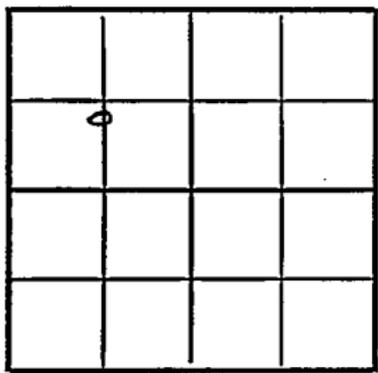

Seward County

Location _____

Rig up _____

Drilling and Remarks:

reported as
#1 Federal Land
Bank

RECORD

Cased _____ in., _____ ft.

Sand _____

Gas _____

Oil _____

Total Depth _____

PRODUCTION

1st 24 hrs. Nat. _____

1st 24 hrs. after shot _____

Gas _____ Cu. Ft.

Dry Hole _____

Abandoned _____

Date

JAN 16 1946

19

S. J. LEWIS

Scout

Kansas Pool Name Wildcat

Map No. 2/10 map Sec. 14 Twp. 35 R. 31W

Well No. 1 Adams Ranch Unit #1

Stanolind Company

ABANDONED

Contractor

C N L S $\frac{1}{2}$ NW

E 12679
SECTION PLAT

1800 Ft. from N. Line

_____ Ft. from S. Line

_____ Ft. from E. Line

1320 Ft. from W. Line

Seward County

Location _____

Rig up _____

Drilling and Remarks:

5" @ 6145

RECORD

Cased _____ in., _____ ft.

Sand _____

Gas _____

Oil _____

Total Depth 6800

PRODUCTION

1st 24 hrs. Nat. _____

1st 24 hrs. after shot _____

Gas _____ Cu. Ft.

Dry Hole _____

Abandoned _____

Date

APR 10 1946 19

S. J. LEWIS

Scout