

KANSAS

Stevens county✓

15

35

36W

Sec. Twp. R.

Well No. 1 Blackner Farm

Northern Natural Gas Company

Hugton Pool

Ft. from N. Line

100


Ft. from S. Line

100

Ft. from E. Line

Ft. from W. Line

SE NW

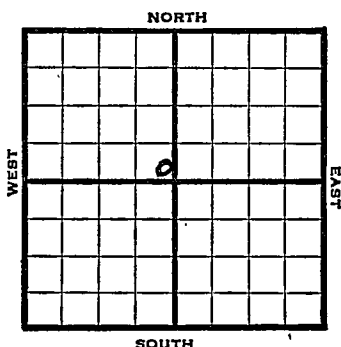

E1 3028'

R E P O R T

1947

6/25

Location

7/1

10" @ 688'
WOC

7/8

TD 2665'
7" @ 2635'

7/16

"

7/22

TD 2802
172' of 5" Per liner @ 2802

7/29

"

8/6

7" @ 2635'
172' of 5" Perf liner @ 2802'
15000 Acid
26,871,000 Gas.
R. Pr. 418#
T.D. 2802'
Complete

COMPLETED

Map No. _____ Sec. 15 Twp. 35 R. 3 6W

Well No. 1 Blackner

Northern Natural Gas Company

FIRST REPORT

Contractor

SE NW


SECTION PLAT

_____ Ft. from N. Line

100 Ft. from S. Line

100 Ft. from E. Line

_____ Ft. from W. Line

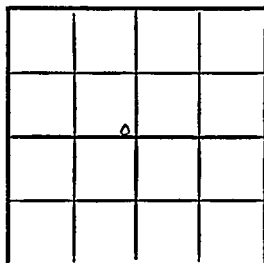

Stevens County

Location X

Rig up _____

Drilling and Remarks:

RECORD

Cased _____ in., _____ ft.

Sand _____

Gas _____

Oil _____

Total Depth _____

PRODUCTION

1st 24 hrs. Nat. _____

1st 24 hrs. after shot _____

Gas _____ Cu. Ft.

Dry Hole _____

Abandoned _____

Date

JUN 25 1947 19 S. I. LEWIS Scout

Kansas


Hugoton Pool

Map No. 0 Sec. 15 Twp. 35 R. 36WWell No. 1 BlacknerNorthern Natural Gas Company

COMPLETE

Contractor

SE NW

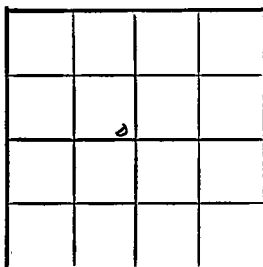E 1/3028
SECTION PLAT Ft. from N. Line100 Ft. from S. Line100 Ft. from E. Line Ft. from W. LineStevens CountyLocation Rig up

Drilling and Remarks:

7" @ 2635172' x 15" Pay line@ 280215000 acrol26,871,000 Gas#18 P/L

RECORD

Cased in., ft.Sand Gas Oil Total Depth 2802

PRODUCTION

1st 24 hrs. Nat. 1st 24 hrs. after shot Gas Cu. Ft.Dry Hole Abandoned

Date

AUG 6 1947

19

S. J. LEWIS

Scout