


Section 15 Township 35 Range 35-W

Well No. #2-A Roy Grant

Company Plains Natural Gas

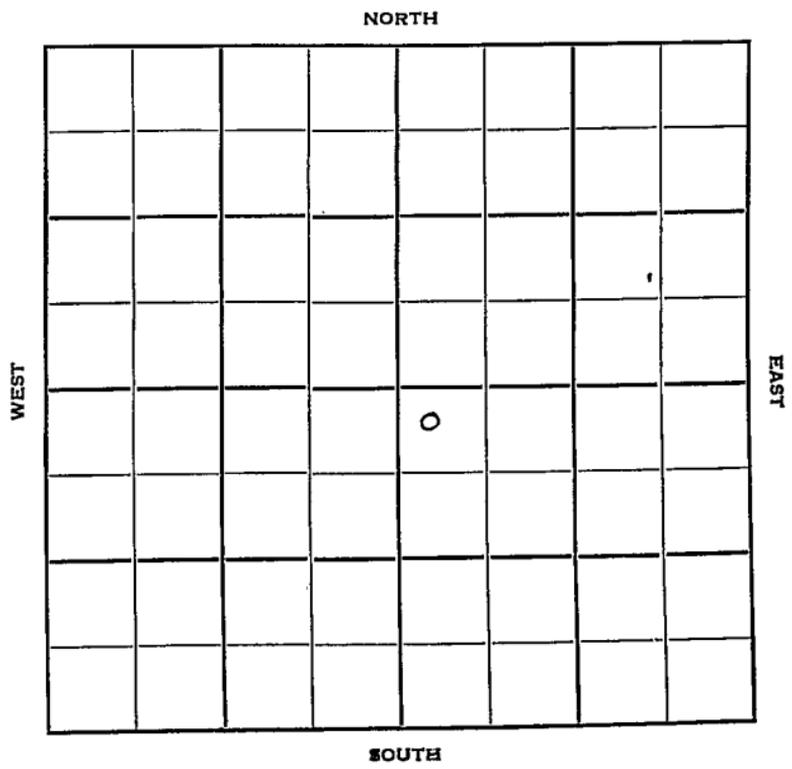

Sec. 15 Twp. 35 R. 35W

Well No. #2-A Roy Grant Farm

Plains Natural Gas Company

Hugoton Pool Contractor

200' Ft. from N. Line


- Ft. from S. Line

- Ft. from E. Line

173' Ft. from W. Line

NW SE

Gas Well

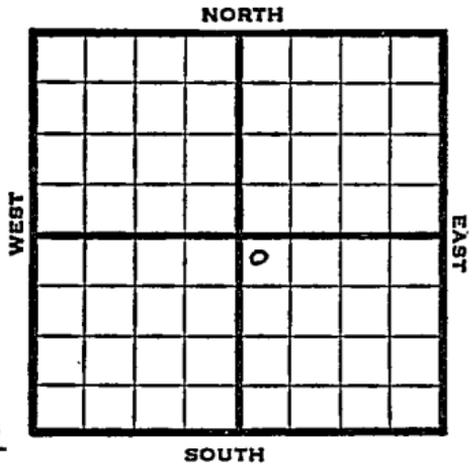

1950

Elev 2975 REPORT

9/6

10-3/4" @ 240'
Drlg. 1500'

19/11

10 3/4" @ 240
7" @ 2792
TD 2796
Hol 2594 Her 2658
Krider 2690 Win 2777
90/2660-75, 30/2691-96, 60/2703-13
270/2719-64
19000 total acid
Comp 2,368,000 gas
Del. test 404#
Completed
COMPLETED

County Stevens State Kansas

Sec. 15 (Blk. Twp.) 35 (Sur. Rge.) 35W Map No.

Operator Plains Natural Gas

Well No. 2-A Farm Roy Grant

Elev. _____ Location NW SE

200 Ft. From N Line SE

173 Ft. From W Line Quarter

1st. Report SEP 6 1950

Completion _____

Remarks _____

Spudding Date _____

Drlg. Data Hugoton Pool

10 3/4" @ 240 drlg. 1500

J. E. TYRA

