

KANSAS


Sweard county

FORM 51 SM 6-46 PETROL

Section 15 Township 35 Range 33-W

Well No. #1, Feather

Company Stanolind Oil and Gas Company

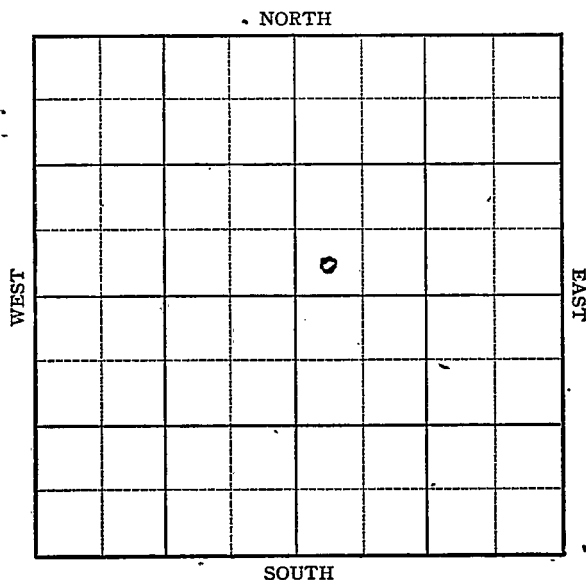

623507

4414	6200	7965	8622
2823	2823	2823	2823
1591	3377	5142	5199


Sec. 15 KANSAS Twp. 35 R. 33WWell No. # 1 Feather Farm
Stanolind Company

Hugoton

Ft. from N. Line

330 Ft. from S. Line

Ft. from E. Line

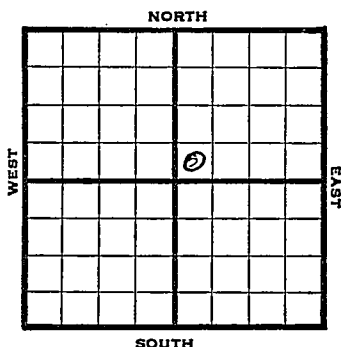330 Ft. from W. Line

SW NE

1946

2823

REPORT

8/28	R U R
	Deep Test
9/5	Drlg 650'
9/10	13" @ 650
	Drlg 2030'
9/18	2670 fsg
9/24	9" @ 2487'
	Drlg 3407'
10/1	Herington 2630'
	Ft Riley 2820'
	Drlg 4300'
10/8	Drlg 4580'
10/15	Lans 4414'
	Drlg 4940'
10/22	Drlg 5550'
10/29	Miss 6200'
	Drlg 6231'
11/6	Drlg 6300'
11/12	6723 Lost Circulations
11/20	Drlg 7024'
11/27	Drlg 7085'
12/3	Drlg 7426'
12/10	Drlg 7741'
12/17	Drlg 7865'

OVER

1947

1/2 Mag. 7834'
 Simp 7965'
 Arb 8022'
 TD 8087 SD
1/8 TD 8243'
 PB 6200 to run csg.

1/15 " " "

1/21 5" @ 6152

1/29 TD 8243'
 9" @ 2487
 Sand 6157
 5" @ 6152
 500 Acid
 4,965,000 Gas
 1575# R Pr

COMPLETED

KANSAS

Kansas

Pool Name HugotonMap No. _____ Sec. 15 Twp. 35 R. 33WWell No. 1 Feather

Stanolind

Company

FIRST REPORT

Contractor


SW NE

SECTION PLAT

_____ Ft. from N. Line

330 Ft. from S. Line

_____ Ft. from E. Line

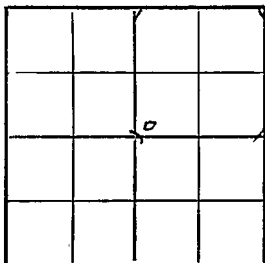330 Ft. from W. Line,Seward County

RECORD

Location _____

Cased _____ in., _____ ft.

Rig up _____

Sand _____

Drilling and Remarks:

Gas _____

Oil _____

Total Depth _____

R U R

PRODUCTION

Deep test.

1st 24 hrs. Nat. _____

1st 24 hrs. after shot _____

Gas _____ Cu. Ft.

Dry Hole _____

Abandoned _____

Date

AUG 28 1946 19

S. J. LEWIS Scout

Misc. Small Maps

Cards Sarah

Tracing _____

France Map ✓

Scarborough Map ✓

Pierce Map ✓

Geological Dept. _____

Pierce Plat Book

Map No. _____ Sec. 15 Twp. 35 R. 33W

Well No. 1 Feather

Stanolind _____ Company


COMPLETE

Contractor

SW NE

E12823

SECTION PLAT

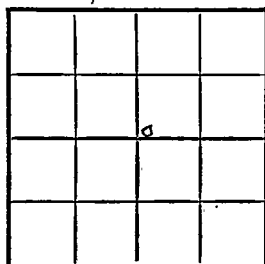

_____ Ft. from N. Line

330 Ft. from S. Line

_____ Ft. from E. Line

330 Ft. from W. Line

Seward County

Location _____

Rig up _____

Drilling and Remarks:

9" @ 2487

Sand 6157

5" @ 6152

5" @ 6000

4, 965,000 Gas

1525 R/P*

RECORD

Cased _____ in. _____ ft.

Sand _____

Gas _____

Oil _____

Total Depth 8243

PRODUCTION

1st 24 hrs. Nat. _____

1st 24 hrs. after shot _____

Gas _____ Cu. Ft.

Dry Hole _____

Abandoned _____

Date

JAN 29 1947 19

S. J. LEWIS Scout

1875

3. Map	☒
Cedarborough Map	☒
Pierce Map	☒
Geological Dept.	☐
Pierce Plat Book	☐