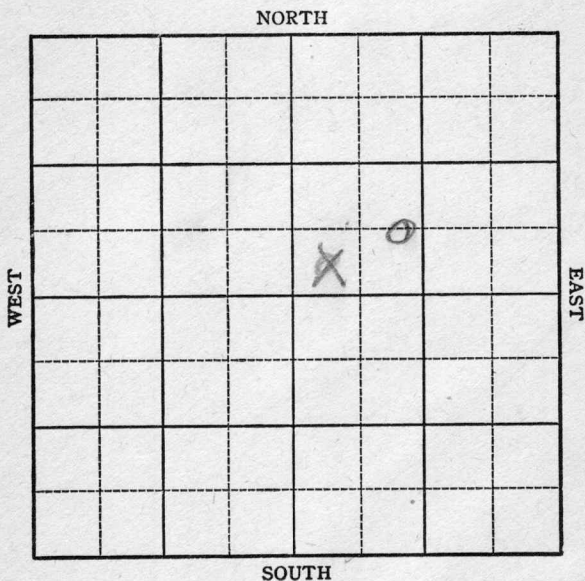


KANSAS

Seward County


Section 15 12 Township 35 Range 32-WWell No. #1 Lofin-EstCompany H. L. Hunt

Sec. 15
12 Twp. 35 R. 32-WWell No. ~~#1 Dolphin Est~~ #1 LIGHT Farm~~H. I. Hunt~~ LOFLIN ETAL Company
Hugoton Pool

Ft. from N. Line

660
330 Ft. from S. Line

Ft. from E. Line

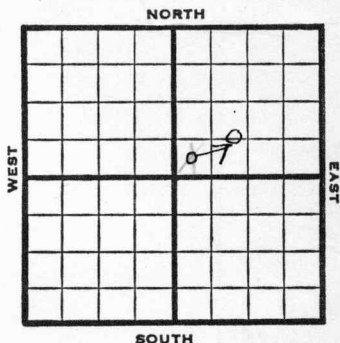990
330 Ft. from W. Line

SW NE

1947 2753 REPORT

1/29	Location
2/5	"
2/12	18" @ 527' Drlg 1570'
2/19	9" @ 2315' Drlg 2323'
2/25	SD
3/4	Drlg 3440'
3/11	Drlg 4095'
3/18	Drlg 4677'
3/25	Drlg 5292'
4/2	Lamsing 4405' Drlg. 6002'.
4/9	TD 6308' run csg.
4/15	Morrow sand 6109' Mississippi 6174' TD 6314' 5" @ 6302' RUST

OVER

4/26 Morrow sand 6109'
Mississippi 6174'
TD 6314'
5" @ 6302'
RUST

4/29 " "

5/7 " "

5/13 " "

5/20 " "

5/27 " "

6/3 " "

6/10 TD 6514'

6/17 "

6/24 "

7/1 "

7/8 "

7/16 "

7/22 "

7/29 "

8/6 "

8/13 "

8/20 "

8/27 "

9/3 "

9/10 6000 acid 6230-80
3,000,000 cu ft Gas

9/17 1000 acid.

9/24 "

10/1 "

10/8 "

10/15 "

10/22 "

Sec. _____ Twp. _____ R. _____

Well No. _____ Farm _____


_____ Company _____

_____ Ft. from N. Line

_____ Ft. from S. Line

_____ Ft. from E. Line

_____ Ft. from W. Line

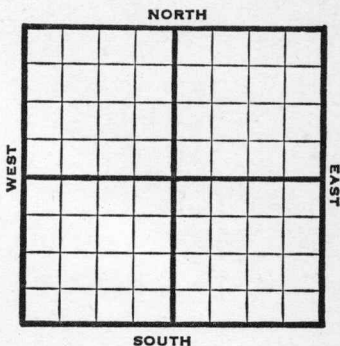

REPORT

1947

10/29 Acid 1000

11/5 "

11/12 "

11/19 "

11/25 "

12/3 "

12/10 "

12/17 "

12/30 "

1948

1/7 "

1/14 "

1/21 "

1/26 "

2/4 "

2/11 "

2/18 "


2/25 Miss. 6174'
5" @ 6302'
TD 6314'
Abd.

ABANDONED

Map No. _____ Sec. 15 Twp. 35 R. 32WWell No. 1 LightLolfin etal. CompanyCORRECTION Contractor

SW NE

SECTION PLAT

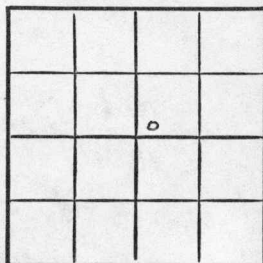 Ft. from N. Line330 Ft. from S. Line Ft. from E. Line330 Ft. from W. Line

Seward County

Location _____

Rig up _____

Drilling and Remarks:

Reported

H. L. Hunt

#1 Lolfin Est.

RECORD

Cased _____ in., _____ ft.

Sand _____

Gas _____

Oil _____

Total Depth _____

PRODUCTION

1st 24 hrs. Nat. _____

1st 24 hrs. after shot _____

Gas _____ Cu. Ft.

Dry Hole _____

Abandoned _____


Date

FEB 12 1947

19

S. J. LEWIS Scout

SECTION PLAT

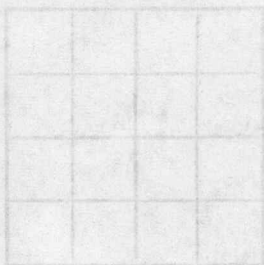

ft. from N. line
ft. from E. line
ft. from S. line
ft. from W. line

RECORD

[Handwritten scribbles]

- Misc. Small Maps
- Cards *[Handwritten initials]*
- Tracing *[Handwritten checkmark]*
- France Map *[Handwritten X]*
- Scarborough Map *[Handwritten X]*
- Pierce Map *[Handwritten checkmark]*
- Geological Dept.
- Pierce Plat Book

Date

Map No. _____ Sec. 12 Twp. 35 R. 32WWell No. 1 Lolfin-Est.

H. L. Hunt

Company

FIRST REPORT

Contractor

SW NE

SECTION PLAT

		0	

_____ Ft. from N. Line

330 _____ Ft. from S. Line

_____ Ft. from E. Line

330 _____ Ft. from W. Line

Seward County

Location X

Rig up _____

Drilling and Remarks:

RECORD

Cased _____ in., _____ ft.

Sand _____

Gas _____

Oil _____

Total Depth _____

PRODUCTION

1st 24 hrs. Nat. _____

1st 24 hrs. after shot _____

Gas _____ Cu. Ft.

Dry Hole _____

Abandoned _____

Date

JAN 29 1947


19

S. J. LEWIS

Scout

REPORT

SECTION PLAT

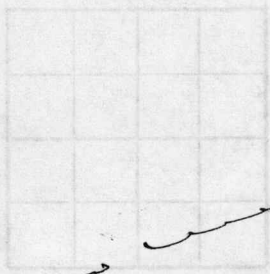

Misc. Small Maps	
Cards	<i>LLG</i>
Tracing	☒
France Map	☒
Scarborough Map	☒
Pierce Map	☒
Geological Dept.	☒
Pierce Plat Book	☒

[Handwritten signature]

[Handwritten text]

Map No. _____ Sec. 15 Twp. 35 R. 32W

Well No. 1 Lolphin Est.

H. L. Hunt


Company

CORRECTION

Contractor

SW NE

SECTION PLAT

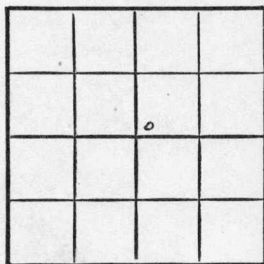

_____ Ft. from N. Line

330 Ft. from S. Line

_____ Ft. from E. Line

330 Ft. from W. Line

Seward County

Location _____

Rig up _____

Drilling and Remarks:

Reported in

12-35-32W

RECORD

Cased _____ in., _____ ft.

Sand _____

Gas _____

Oil _____

Total Depth _____

PRODUCTION

1st 24 hrs. Nat. _____

1st 24 hrs. after shot _____

Gas _____ Cu. Ft.

Dry Hole _____

Abandoned _____

Date

FEB 5 1947 19

S. J. LEWIS Scout

no wall



- Misc. Small Maps ☒
- Cards ☒
- Tracing ☒
- France Map ☒
- Scarborough Map ☒
- Pierce Map ☒
- Geological Dept. ☐
- Pierce Plat Book ☐

No Map
Map No. _____ Sec. 15 Twp. 35 R. 32W

Well No. 1 Light

Lolfin et al. Company

ABANDONED Contractor

C E L SW NE


E 1,2703
SECTION PLAT

_____ Ft. from N. Line

660 Ft. from S. Line

_____ Ft. from E. Line

990 Ft. from W. Line

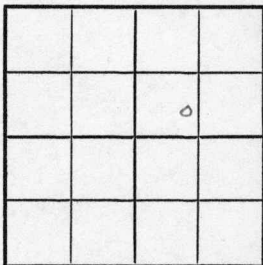

Seward County

Location _____

Rig up _____

Drilling and Remarks:

Miss 6174
5' @ 6302

RECORD

Cased _____ in., _____ ft.

Sand _____

Gas _____

Oil _____

Total Depth 6314

PRODUCTION

1st 24 hrs. Nat. _____

1st 24 hrs. after shot _____

Gas _____ Cu. Ft.

Dry Hole _____

Abandoned _____

Date

FEB 25 1948

19

S. J. LEWIS Scout


Map No. _____ Sec. _____ Twp. _____ R. _____

Well No. _____

Company _____

Contractor _____

SECTION PLAT

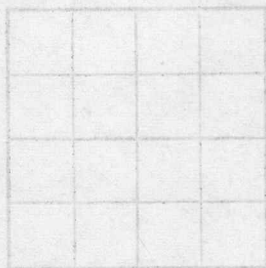

Feet from N. line _____

Feet from S. line _____

Feet from E. line _____

Feet from W. line _____

RECORD

Cased _____ in _____ ft.
 Sand _____
 Gas _____
 Oil _____
 Total Depth _____

Location _____

Rig up _____

Drilling and Remarks: _____

Misc. Small Maps _____

Cards _____

Tracing _____

France Map _____

Scarborough Map _____

Pierce Map _____

Geological Dept. _____

Pierce Plat Book _____

Date _____

Map No. _____ Sec. 15 Twp. 35 R. 32W

Well No. 1 Light

Lolfin etal. Company

CORRECTION Contractor

C ~~E~~ L SW NE

SECTION PLAT

		o	

_____ Ft. from N. Line

660 Ft. from S. Line

_____ Ft. from E. Line

990 Ft. from W. Line

Seward County

Location _____

Rig up _____

Drilling and Remarks:

Reported
SW NE

RECORD

Cased _____ in., _____ ft.

Sand _____

Gas _____

Oil _____

Total Depth _____

PRODUCTION

1st 24 hrs. Nat. _____

1st 24 hrs. after shot _____

Gas _____ Cu. Ft.

Dry Hole _____

Abandoned _____

Date

FEB 1 9 1947 19 S. J. LEWIS Scout

Misc. Small Maps

Cards

Tracing

France Map

Scarborough Map

Pierce Map

Geological Dept.

Pierce Plat Book