
FORM 51 25M 8-50 WESTERN Morton KANSAS

Section 16 Township 35 Range 41W

Well No. #1 Hayward (C)

Company Cities Service Oil

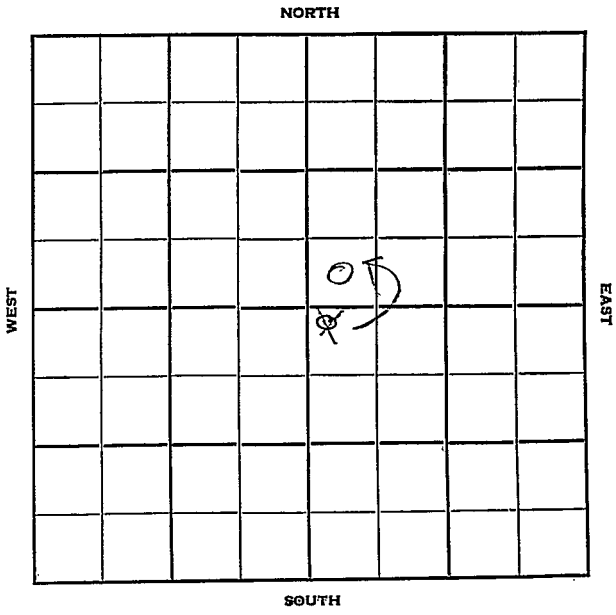

FORM 252-B
10M 10-50 PETROL

Morton KANSAS

Sec. 16 Twp. 35 R. 41W

Well No. #1 Hayward (C) Farm

Cities Service Oil Company

Barbour - Contr. Contractor


~~100'~~ Ft. from N. Line

100 Ft. from S. Line

Ft. from E. Line

100' Ft. from W. Line

~~NW SE~~
SW SW NE

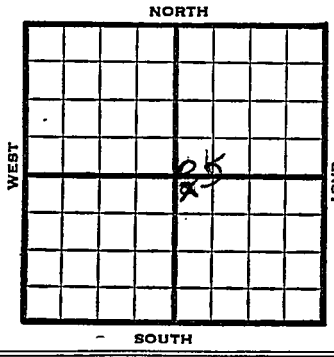

1952	Elev. 3520' REPORT
2/27	Location
3/5	8" @ 400 w/200 5" @ 2453 RTD 2455 Up Krider 2314 Winfield 2368
3/12	DO to 2417 100/2378-98 4500 A 170/2314-48
3/19	17,500 A
4/2	Spud 2-26-52 Gas Well TD 2455 8" @ 400 5½" @ 2453 TD 2455 Kri 2314 Win. 2368 CO to 2417 100/ 2378-98 170/ 2314-48 17500 A Comp. 4,958,000 gas

COMPLETED

FORM 275 FOR SALE BY KANSAS BLUE PRINT CO.


County Morton State Kansas

Sec. 16 (Blk. Twp.) 35 (Sur. Rge.) 41W Map No.

Operator Cities Service Oil

Well No. 1 Farm Hayward (C)

Elev. Location NW SE

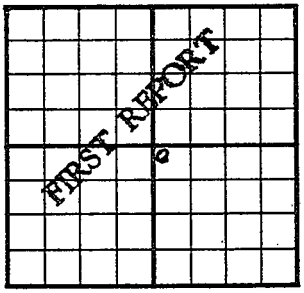

100 Ft. From N Line SE

100 Ft. From W Line Quarter

1st. Report FEB 27 1952

Completion

Remarks

Barbour - Contr.

Spudding Date

Drlg. Data

Location

J. G. McGEHEE

FORM 26 PETROL
200 BKS. 7-51

Morton

Map No. _____ Sec. 16 Twp. 35 R. 41W


Well No. 1 Hayward "C"

C. S. D.
Company

Contractor

SW SW NE

SECTION PLAT

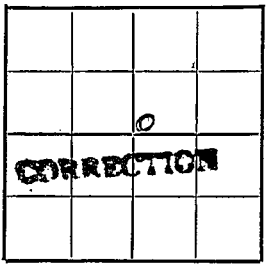

_____ Ft. from N. Line

100 Ft. from S. Line

_____ Ft. from E. Line

100 Ft. from W. Line

Location _____

Rig up _____

Drilling and Remarks:

Reported
NW NW SE

RECORD

Cased _____ in., _____ ft.

Sand _____

Gas _____

Oil _____

Total Depth _____

PRODUCTION

1st 24 hrs. Nat. _____

1st 24 hrs. after shot _____

Gas _____ Cu. Ft.

Dry Hole _____

Abandoned _____

Date

3-9-52 19 J. J. M. Scout

Form 26 200 Blk. 11-49 Petrol

Kansas

Map No. _____ Sec. 16 Twp. 35 R. 41W


Well No. 1 Hayward "C"

Cities Service Oil Company

CORRECTION Contractor

SW SW NE

SECTION PLAT

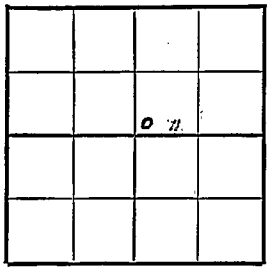

_____ Ft. from N. Line

100 Ft. from S. Line

_____ Ft. from E. Line

100 Ft. from W. Line

Morton County

Location _____

Rig up _____

Drilling and Remarks:

Reported

NW SE

RECORD

Cased _____ in., _____ ft.

Sand _____

Gas _____

Oil _____

Total Depth _____

PRODUCTION

1st 24 hrs. Nat. _____

1st 24 hrs. after shot _____

Gas _____ Cu. Ft.

Dry Hole _____

Abandoned _____

Date

APR 2 1952

19

J. G. McGEHEE Scout

FORM 275 FOR SALE BY KANSAS BLUE PRINT CO.


County Morton State Kansas

Sec. 16 (Blk. Twp.) 35 (Sur. Rge.) 41W Map No.

Operator Cities Service Oil

Well No. 1 Farm Hayward "C"

Elev. 3520 Location SW SW NE

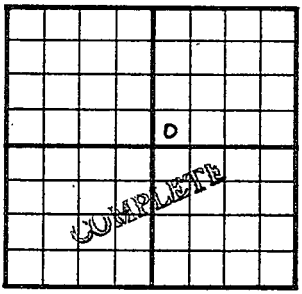

100 Ft. From S Line NE

100 Ft. From W Line Quarter

1st. Report

Completion APR 2 1952

Remarks

Barbour - Contr.

Spudding Date 2-26-52

Drlg. Data Gas well TD 2455

8" @ 400 5½" @ 2453 TD 2455

Krider 2314 Win. 2368 DO to 2417

100/ 2378-98 170/ 2314-48 17500 A

Comp. 4,958,000 gas

J. G. McGEHEE