~~Ottawa~~ Morton

Form 51—5M—1-30—38840

Map No. KANSAS Sec. 16 Twp. 35 R. 39W

Well No. 1 - Phillips Farm

Texas Interstate P.L. Company

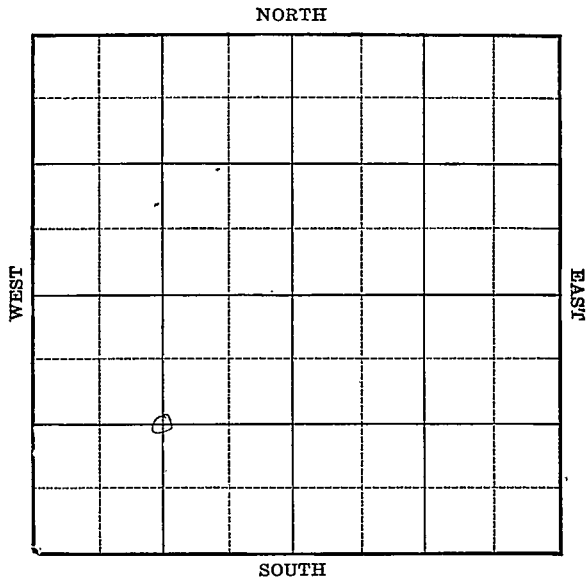

Location

Drilling Remarks

Rig Up

Drilling Remarks

RECORD

Cased ____ in. ____ ft.

Sand

Gas

Oil

Total Depth

PRODUCTION

1st 24 hrs. Nat.

1st 24 hrs. after shot

Gas ____ cu. ft.

Dry Hole

Abandoned

Form 252A—5M—11-29—38055

Morton Co

Map No. KANSAS Sec. 16 Twp. 35 R. 39W

Well No. 1-Phillips Farm

Texas Interstate P.L. Co Company

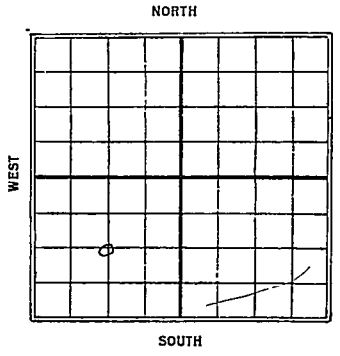

_____ Ft. from N. Line

1320 Ft. from S. Line

_____ Ft. from E. Line

1320 Ft. from W. Line

1930

Date	REPORT
11/5	Loc
11/12 11/19	Rigging up.
11/25	12"- 607'
12/3	Dly 1996
12/10	" 2280
12/17	" 2350'
12/23	8"- 2597 Rush
12/30	Sand 2597-2795
	T.D. 2795
	10½" H Gas
	Comp.

Form 26 1M Bks. 9-28

Stevens

Map No. KANSAS Sec. 16 Twp. 35 R. 39 W

Well No. 1 Phillips

Texas Interstate Pipe Line Company

.....Contractor

SECTION PLAT

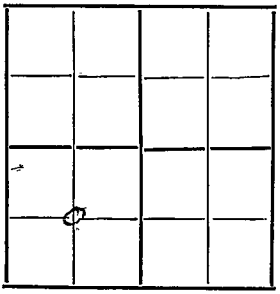

.....Ft. from N. Line

1320 Ft. from S. Line

.....Ft. from E. Line

1320 Ft. from W. Line

FIRST REPORTS

Location

Rig up

Drilling and Remarks:

RECORD

Cased.....in., ...ft.

Sand

Gas

Oil

Total Depth

PRODUCTION

1st 24 hrs. Nat.

1st 24 hrs. after shot

Gas.....Cu. Ft.

Dry Hole

Abandoned

Date

NOV 5 1930

S. J. LEWIS Scout

no deed
no survey

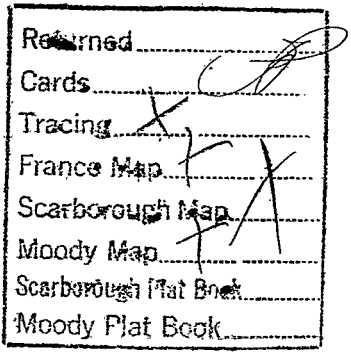

Form 26 1M Blk 9-28

Map No. KANSAS Sec. 16 Twp. 35 R. 39 W

Well No. 1 Phillips Pet

Texas Interstate Pipe Line Company

.....Contractor

SECTION PLAT

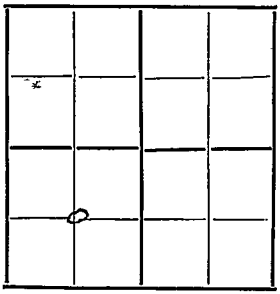

.....Ft. from N. Line

1320 Ft. from S. Line

.....Ft. from E. Line

1320 Ft. from W. Line

CORRECTION

Location.....

Rig up.....

Drilling and Remarks:

Reported in Stevens County

RECORD

Cased.....in., ...ft.

Sand.....

Gas.....

Oil.....

Total Depth.....

PRODUCTION

1st 24 hrs. Nat.....

1st 24 hrs. after shot.....

Gas.....Cu. Ft.

Dry Hole.....

Abandoned.....

Date

NOV 1 2 1930 192....

S. J. LEWIS Scout

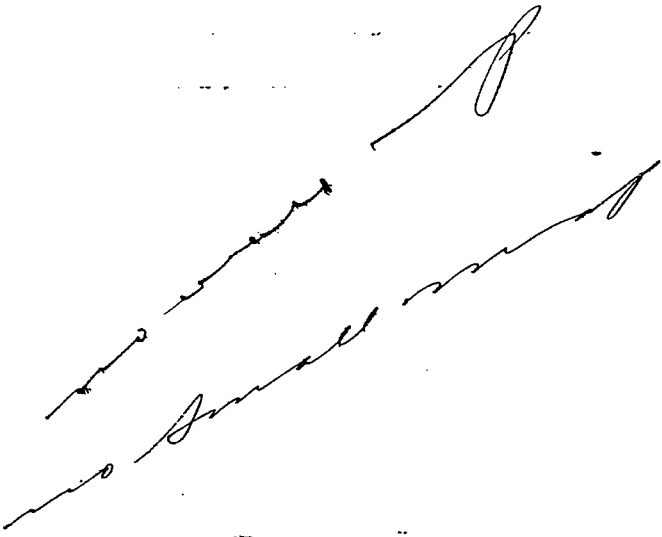

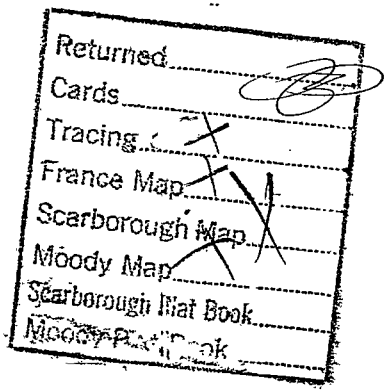
Returned
Cards
Tracing
France Map
Scarborough Map
Moody Map
Scarborough Plat Book
Moody Plat Book

Form 26—1M Blks.—9-28

Moe Con

Map No KANSAS Sec. 16 Twp. 35 R. 39 W

Well No. 1 Phillips

Texas Interstate Pipe Line Company

Contractor

SECTION PLAT

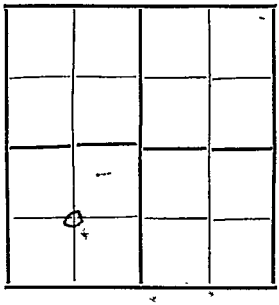

Ft. from N. Line

1320 Ft. from S. Line

Ft. from E. Line

1320 Ft. from W. Line

COMPLETED

Location

Rig up

Drilling and Remarks:

RECORD

Cased in., ft.

Sand 2592 - 2795

Gas 10½ M

Oil

Total Depth 2795

PRODUCTION

1st 24 hrs. Nat.

1st 24 hrs. after shot

Gas Cu. Ft.

Dry Hole

Abandoned

Date

DEC 30 1930 192

S. J. LEWIS Scout

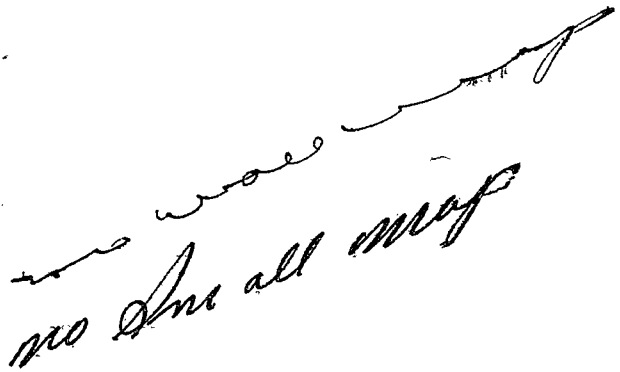

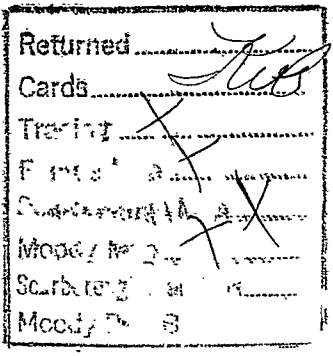
Returned
Cards
Tracing
