


Section 16 Township 35 Range 37-W
Well No. #1 Clagett
Company Republic Natural Gas

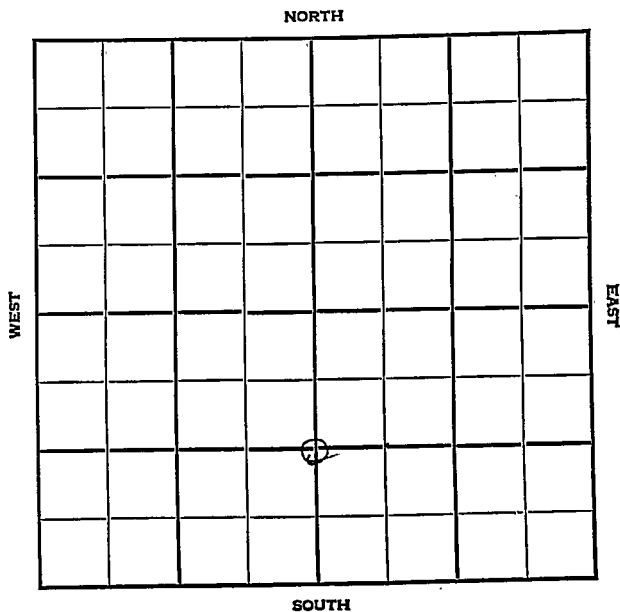

KANSAS

Stevens



Sec. 16 Twp. 35 R. 37W

Well No. #1 Clagett Farm

Republic Natural Gas Company

Hugoton Pool


 Ft. from N. Line

1320' Ft. from S. Line

2640' Ft. from E. Line

 Ft. from W. Line

C S $\frac{1}{2}$ Sec.

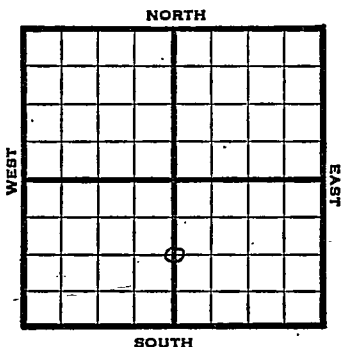

1948

Eli 3127'

REPORT

7/14

10" @ 699'

Dr1g. 2460'

7/21

TD 2675'

7"@ 2670'

7/28

TD 2900'

255' of 5" Perf Line @ 2900'

3000 acid

8/4

"

8/11

16000 acid

8/18

7"@ 2670'

255' of 5" Perf liner @ 2900'

TD 2900'

19000 acid

28,121,000 gas

380 # R Pr.

Comp

COMPLETED

Map No. _____ Sec. 16 Twp. 35 R. 37W

Well No. 1 Clagett


Republic Natural Gas Company

FIRST REPORT

Contractor _____

C S $\frac{1}{2}$ Sec.

SECTION PLAT

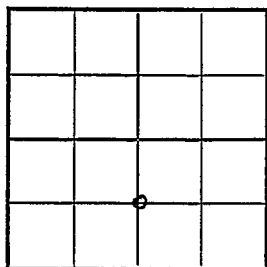

_____ Ft. from N. Line

1320 Ft. from S. Line

2640 Ft. from E. Line

_____ Ft. from W. Line

Stevens County

RECORD

Location _____

Rig up _____

Drilling and Remarks:

10" @ 699
drlg. 2460

Cased _____ in., _____ ft.

Sand _____

Gas _____

Oil _____

Total Depth _____

PRODUCTION

1st 24 hrs. Nat. _____

1st 24 hrs. after shot _____

Gas _____ Cu. Ft.

Dry Hole _____

Abandoned _____

Date

JUL 1 4 1948

19

S. J. LEWIS

Scout

Stevens County Kansas State

Map No. Sec. 16 Twp. 35 R. 37W

Well No. 1 Claggett

Republic Natural Gas Company

COMPLETE Contractor


C S $\frac{1}{2}$ Sec.E 13127
SECTION PLAT

Ft. from N. Line

1320 Ft. from S. Line

2640 Ft. from E. Line

Ft. from W. Line

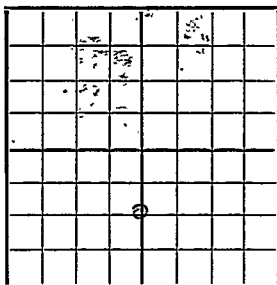

Hugoton Pool

Remarks:

7" @ 2670

255' x 5" Pay liner @ 2800

7" @ 2900

19000 ac oil

28,121,000 Gas

380 * R/B

Date

AUG 18 1948

Scout

S. J. LEWIS