

Stevens


FORM 51 IOM 12-46 PETROL

KANSAS

Section 16-~~2~~ Township 35 Range 36W

Well No. 2 Blackmer

Company Northern Natural Gas

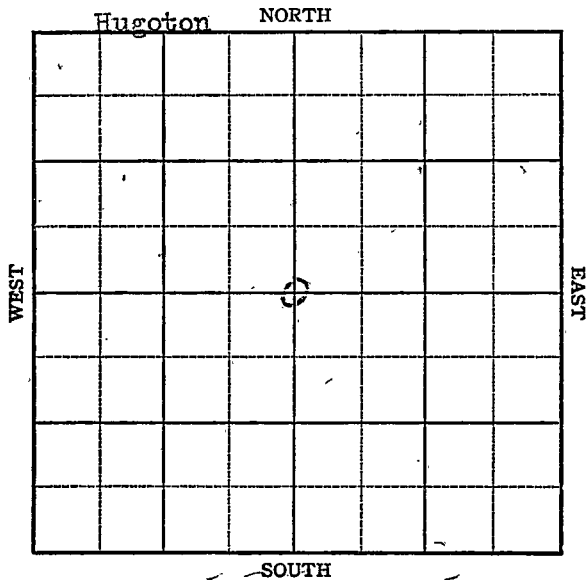

Sec. 16 Twp. 35 R. 36-W

Well No. #2 Blackmer Farm

Northern Natural Gas Company

Hugoton Pool


2640 Ft. from N. Line

_____ Ft. from S. Line

2640 Ft. from E. Line

_____ Ft. from W. Line

C Sec.

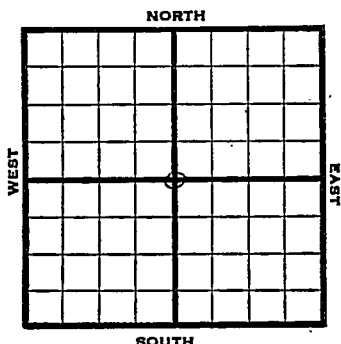

1947 El 3050' REPORT

6/18 Location

6/24 10" @ 682'
Drlg. 2660'

7/1 TD 2670'
7" @ 2655'

7/8 "

7/16 Drlg 2765'

7/22 TD 2815'
172' of 5" Perflinor @ 2815
15000 acid

7/29 "

8/6 7" @ 2655'
172' of 5" Perf liner 2815'
15000 Acid.
30,968,000 Gas.
R. Pr. 401#
T.D. 2815'
Complete

COMPLETED

Kansas


Map No. _____ Sec. 16 Twp. 35 R. 36WWell No. 2 Blackmer_____
Northern Natural Gas Company

FIRST REPORT

Contractor

C Sec.

SECTION PLAT

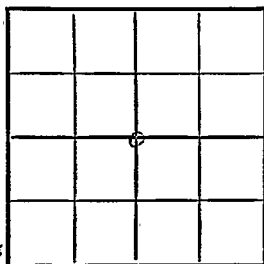2640 Ft. from N. Line_____
Ft. from S. Line2640 Ft. from E. Line_____
Ft. from W. LineStevens CountyLocation X

Rig up _____

Drilling and Remarks:

RECORD

Cased _____ in. _____ ft.

Sand _____

~~Gas~~ _____

Oil _____

Total Depth _____

PRODUCTION

1st 24 hrs. Nat. _____

1st 24 hrs. after shot _____

Gas _____ Cu. Ft.

Dry Hole _____

Abandoned _____

Date


JUN 18 1947 19S. J. LEWIS Scout

Map No. 0 Sec. k 16 Twp. 35 R. 36WWell No. 2 BlackmerNorthern Natural Gas Company

COMPLETE

Contractor

C Sec.

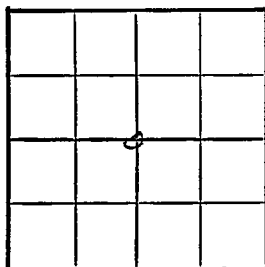E 1,8058
SECTION PLAT2640 Ft. from N. Line Ft. from S. Line2640 Ft. from E. Line Ft. from W. LineStevens CountyLocation Rig up

Drilling and Remarks:

5" @ 2655172' 2 1/2" Perforated@ 281515000 acid30,968,000 Gas4.1 # 8 1/2

RECORD

Cased in., ft.Sand Gas Oil Total Depth 2815'

- PRODUCTION

1st 24 hrs. Nat. 1st 24 hrs. after shot Gas Cu. Ft.Dry Hole Abandoned

Date

AUG 6 1947

19

S. J. LEWIS

Scout