


Section 16 Township 35 Range 34WWell No. #1 E. BolesCompany Plains Natural Gas

NORTH

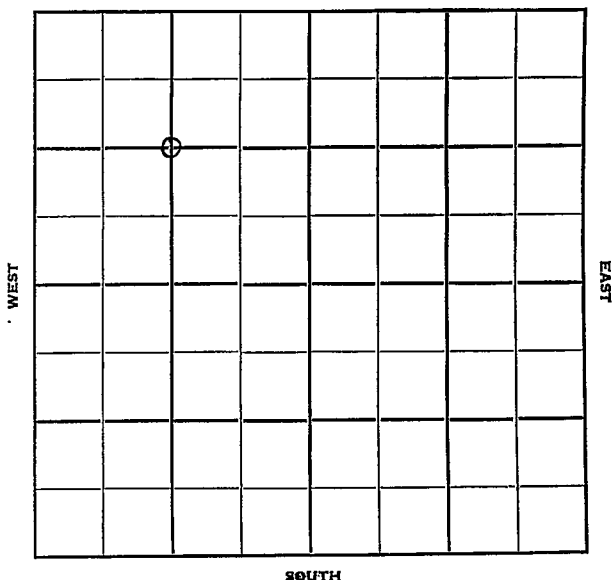

KANSAS
35

Seward

16

34-W ✓

Sec. _____ Twp. _____ R. _____

#1 E. Boles

Well No. _____ Farm _____

Plains Natural Gas

Company _____

Hugoton

Contractor _____

1320

Ft. from N. Line


Ft. from S. Line

Ft. from E. Line

1320

Ft. from W. Line

C NW/4

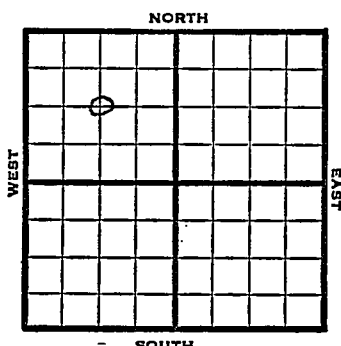

1950

Elev. 2905

REPORT

12/13

Spud 12-10-50

10" @ 672'

1951

1/31

Spud 12/10/50

Gas well TD 2710

10" @672

7" @2708 TD 2710

60/ 2696-2706 90/ 2669-84

120/ 2635-55


Ho1. 2570 Her. 2635 Krider 2668

19000 A

Comp. 1,215,000 gas

COMPLETED

County Seward State Kansas
 Sec. 16 (Blk. 35 (Sur. 34W Map No.
 (Twp.) (Rge.)
 Operator Plains Natural Gas
 Well No. 1 Farm E. Boles
 Elev. Location C NW/4

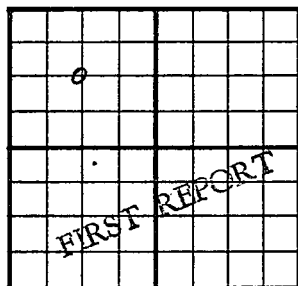

1320 Ft. From N Line NW
1320 Ft. From W Line Quarter

1st. Report DEC 13 1950

Completion

Remarks


Spudding Date 12-10-50

Drig. Data Hugoton Pool

10" @ 672

J. E. TYRA

County Seward State Kansas
 Sec. 16 (Blk. Twp.) 35 (Sur. Rge.) 34W Map No. _____
 Operator Plains Natural Gas
 Well No. 1 Farm E. Boles
 Elev. 2905 Location C NW/4

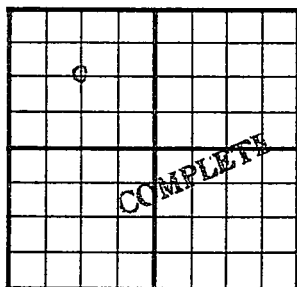

1320Ft. From N Line NW
1320Ft. From W Line Quarter

1st. Report

Completion JAN 31 1951

Remarks Hugoton Pool

Spudding Date 12-10-50

Drlg. Data Gas well TD 2710

10" @ 672 7" @ 2708 TD 2710

60/ 2696-2706 90/ 2669-84 120/ 2635-55

Hol. 2570 Her. 2635 Krider 2668

19000' Aev Comp. 1,215,000 gas

J. E. TYRA