

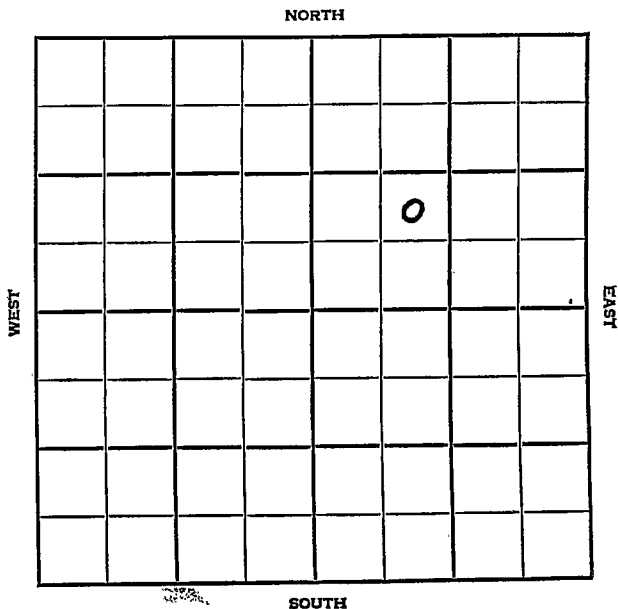
Comanche KANSAS

DX 78-1

Section 16 Township 35 Range 16W

Well No. 1 McMoran

Company Champlin Ref.



Comanche

KANSAS

SEC.	TWP.	R.
16	35	16 W

WELL NO.

COMPANY

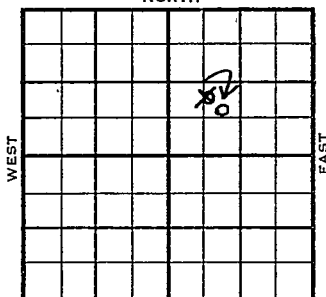
1 McMoran

FARM

CONTRACTOR

Champlin Ref.
Loffland Bros.

NORTH

~~1500~~ Ft. from N. Line

792 Ft. from S. Line

~~1641~~
~~1840~~ Ft. from E. Line

Ft. from W. Line

NE SW NE

SOUTH

ELEVATION

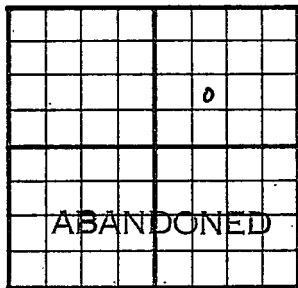
REPORT

1954

1899'

8/4 Drilling
9/15 Spud 7-31-54
D & A
TD 6208'
9-5/8" @ 2510'
Elgin sd. 4177'. Heeb 4376', Tor 4388'
DST 4379'-4433' opn 1 hr, rec 360' sw,
1578# Doug 4433', KC 4587'
DST 4942-5012' opn 1½ hr, rec 180' gas,
80' gcm, 180' muddy SW 1450# Viola
5753'
DST 5037'-61' opn 1½ hr, gas in 5 min
rec. 80' o & gcm 60' ho & gcm, 30' sw
1163# B KC 5111', Marm 5128', Miss
5310', Simp sh. 5927' Simp dol 5931'
Arb. 6125',
DST 6124'-35' opn 1½ hr, rec 75' gas,
in pipe. 15' sgcm 122#
TD 6207'
DD 6208'
DST 6135'-6208' opn 1½ hr, rec 330' gas
35' g & socm, 90' gcm & SD & swcm
60' g & swcm 1743#
DST 5890'-5912' opn 1½ hr, rec 80'
D gas, 100' sgcm 0#
D & A

ABANDONED

County Comanche State KansasSec. 16 (Blk.) 35 (Sur.) 16W Map No.Operator Champlin Ref.Well No. 1 Farm McMoranElev. 1899 Location NE SW NE792 Ft. From S Line NE1641 Ft. From E Line Quarter

1st. Report

Completion SEP 15 1954

Remarks

Loffland Bros. - ContrSpudding Date 7-31-54Drlg. Data D & A TD 62089 5/8" @ 2510 Elgin sd. 4177Heeb. 4376 Tor. 4388 DST 4379-4433 open 1 hr. Rec. 360' sw1578# Doug. 4433 KC 4587DST 4942-5012 open 1 1/2 hr. Rec.180' gas 80' gcm 180' muddy sw1450# Viola 5753 DST 5037-61open 1 1/2 hr. gas in 5 min. Rec.80' o & gcm 60' ho & gcm 30' sw1163# B KC 5111 Marm. 5128Miss. 5310 Simp. sh. 5927Simp. dol. 5931 Arb. 6125DST 6124-35 open 1 1/2 hr. 75' gasin pipe 15' sgcm 122# TD 6207

FABEN GILSTRAP

SEP 22 1954

DD 6208 DSI 6135-6208 open 1 1/2 hr.
Rec. 3301 gas 351 g & soom 901
gcm & SO & swcm 601 gcm
DST 5890-5912 open 1 1/2 hr. Rec. 801
gas 1001 soom
Tracings #0
Land-Wall Map
Land Small Map
Scout Cards

Orig. Data

KANDAG

Map No. _____ Sec. 16 Twp. 35 R. 16WWell No. 1 McMoran

Champlin Ref.

Company

CORRECTION

Contractor

NE SW NE

SECTION PLAT

_____ Ft. from N. Line

792 Ft. from S. Line1641 Ft. from E. Line

_____ Ft. from W. Line

Comanche County

Location _____

Rig up _____

Drilling and Remarks:

Reported

1500 NL

1840 EL

RECORD

Cased _____ in., _____ ft.

Sand _____

Gas _____

Oil _____

Total Depth _____

PRODUCTION

1st 24 hrs. Nat. _____

1st 24 hrs. after shot _____

Gas _____ Cu. Ft.

Dry Hole _____

Abandoned _____

Date

AUG 11 1954

19

78

Scout

County **Comanche** State **Kansas**

Sec. 16 (Blk. Twp.) 35 (Sur. Rge.) 16W Map No.

Operator Chemolin Ref.

Well No. 1 Farm McMoran

Elev.	7899	Location	NE SW NE
-------	------	----------	----------

FIRST REPORT

1500 Ft. From W Line NE

7840 Ft. From E Line Quarter

1st. Report AUG 4 1954

Completion

Remarks

Spudding Date . . .

Drlq. Data

drlg.

J. G. McGEHEE