

Section 16 Township 35 Range 3 WWell No. # 1 WilliamsCompany Ben Brack

NORTH

		0					

WEST

EAST

SOUTH

Sec. 16 Twp. 35 R. 3W

Well No. #1 Williams Farm

Ben Brack Company

Contractor

Caldwell Pool


330 Ft. from N. Line

Ft. from S. Line

990 Ft. from E. Line

Ft. from W. Line

NW NE SW

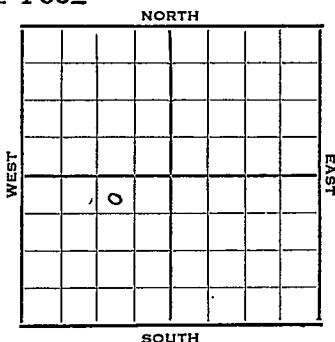

1952 Elev. 1132' REPORT

6/4 Spud 6-2-52
8" @ 360'

6/11 Drlg. 2950'

6/18 Drlg. 4282'

6/25 Miss 4343'
Drlg. 4495'7/2 KH 4680' V 4738' Simp 4747'
RTD 4750' 5" @ 4749 WOC

7/9 NR

7/17 DD 4760' TD Lot of wtr. To PB

7/23 NR

7/30 Spud 6-2-52 Oil Well TD 4760
8" @ 360 Miss 4343DST 4347-80 open 3/4 hr. rec. 90' mud
400#DST 4399-4415 open 1 hr. rec. 800,000
gas 125' o & gcm 1970#DST 4415-20 open 1 hr. rec. 510' gas
120' o&gcmDST 4420-35 open 1 hr. rec. 120' ocm
90' oily mud 90' wtr.

Kh 4680 Viola 4738

Simp. 4747 TD 4750

5" @ 4749 DD 4760

PB 4460 12/ 4400-08

42/ 4398-4420 FU 40' fluid


11/ 4397-4401 gas in 30 min.

OVER

1952

7/30 60,000 gas 42/ 4408-12 FU 45'
fluid 50% oil 16/ 4410-16
S/ 40 bfpd 12 bo 2000 A
F/ 35 bo 1 hr. F/ 20 bo 2nd hr.
F/ 346 bf 22 hr. 80 bo
Comp. 80 bopd 250 bw

COMPLETED

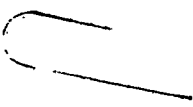



Sec. **16** (Blk.) **35** (Sur.) **3W** Map No.

Well No. 7 Farm Williams

0

FIRST REPORT

Spudding Date 6-2-52

R¹¹ @ 360

J. G. McGEHEE

Scout Cards	<i>ms</i>
Land Small Map	
Land Wall Map	<i>BR</i>
Tracings	
France Map	
Pierce Map	
Misc	

JUN 5 1952

Drig. Data

County	Sumner		State	Kansas	
Sec.	16	(Blk. Twp.)	35	(Sur. Rge.)	3W Map No.
Operator	Ben Brack				
Well No.	1	Farm	Williams		
Elev.	1132	Location	NW NE SW		

	330 Ft. From	N Line	SW
	990 Ft. From	E Line	Quarter
	1st. Report		
	Completion	JUL 30 1955	
Remarks		Caldwell Pool	
Spudding Date		6-2-52	
Drilg. Data	Oil well	TD 4760	

8" @ 360 Miss. 4343 DST 4347-80

open 3/4 hr. Rec. 93' mud 400#

DST 4399-4415 open 1 hr. Rec. 880,000 g

125' o & gcm 1970# DST 4415-20 open

1 hr. Rec. 510' gas 120' o & gcm

DST 4420-35 open 1 hr. Rec. 120' ocm

90' oily mud 908 Water Kh. 4680

Viola 4738 Simp. 4747 TD 4750

5" @ 4749 DD 4760 PB 4460 12/ 4400-08

42/ 4398-4402 FU 40' fluid 11/ 4397-

4401 gas in 30 min. 60,000 gas

42/ 4408-12 FU 45' fluid 50% oil

16/ 4410-16 S/ 40 bfpd 12 bo 2000 A

J. G. McGEHEE

Scout Cards	
Land Small Map	
Land Wall Map	
Tracings	
France Map	
Pierce Map	
Misc.	

AUG 7 1952

Comp. 80 bopd 250 bw
 F/ 346 bf 22 hr. 80 bo
 F/ 35 bo 1 hr. F/ 20 bo 2nd hr.

Orig. Data



17

Texas Company #1. Williams
16-35S-3W, Sumner County, Kansas
drilling @ 4729

on card
mm



THIS SIDE OF CARD IS FOR ADDRESS

Mr. Sam Baird
Box 381
Tulsa 2, Oklahoma

