

Section 16 Township 35 Range 33W

Well No. 1 Chloe Swarts

Company ALADDIN PETR
Stanolind

Hugot on

NORTH

WEST

EAST

						0	

SOUTH

Sec. 16 Twp. KANSAS 35 R. 33W

Well No. #1 Chloe Swarts Farm

~~Stanolind~~
ALADDIN PETR Company


~~J Hugoton Pool~~
WILDCAT

990 Ft. from N. Line

_____ Ft. from S. Line

990 Ft. from E. Line

_____ Ft. from W. Line

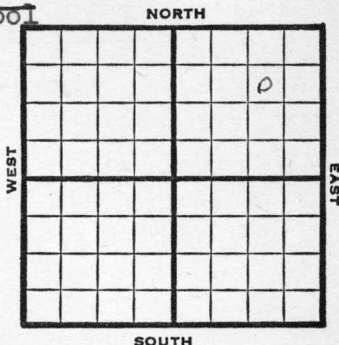

SW NE NE

TRANS-ERA - CONTR

1947 Elev. 2832' REPORT

- 11/5 Location
Deep test
- 11/12 13" @ 646'
WOC
- 11/19 Drlg. 2447'
- 11/25 8" @ 2495'
Drlg. 2625'
- 12/3 Drlg. 4099'
- 12/10 Drlg. 4990'
- 12/17 Drlg. 5842'
- 12/30 Narrow sand 6186'
Drlg. 6218'
Miss. 6224'
TD 6345'

1948
1/7 PB 2870'

1/14 500 acid
Swb 7 W PH

1/21 Miss. 6224'
TD 6282'
Abd.

ABANDONED

OVER

#1 Swartz

O.W.W.O.

1953
5/27

KC 4414, Morrow sh 5890, Morrow
Sd 6171, Miss 6224
OTD 6345
RUR to work over

6/3 CO 6345'

6/10 5" @ 6320'

6/24 NR

7/1 NR

7/8 NR

10/7

Gas Well

TD 6345'

KC 4414, Morrow sh. 5890, Morrow Sd.
6171', Miss 6224'

OTD 6345'

CO to 6345'

5" @ 6320'

CO to 6304'

Morrow 6164', corr. Miss 6224'

29/ 6192-6202 wtr.

55/ 6166'-76' 55/ 6194-6202 st-frac

3000 A 588,000 gas 3000 A st-frac

6000 A 62/ 6267-78 4000 A $\frac{1}{2}$

mcf

Comp. 600,000 gas

COMPLETED

OWW

OCT 14 1953

Scout Card
.....
and Vail
racings
France Map
Pierce Map
Misc.

Handwritten initials "BR" are present in the right column of the form.

Map No. _____ Sec. 16 Twp. 35 R. 33W

Well No. 1 Chloe Swarts

Stanolind Company

FIRST REPORT Contractor

SW NE NE

SECTION PLAT

990 Ft. from N. Line

_____ Ft. from S. Line

990 Ft. from E. Line

_____ Ft. from W. Line

			o

Seward County

Location X

Rig up _____

Drilling and Remarks:

Deep test

RECORD

Cased _____ in., _____ ft.

Sand _____

Gas _____

Oil _____

Total Depth _____

PRODUCTION

1st 24 hrs. Nat. _____

1st 24 hrs. after shot _____

Gas _____ Cu. Ft.

Dry Hole _____

Abandoned _____

Date

NOV 5 1947 19

S. J. LEWIS Scout
















Date

Map No. _____ Sec. 16 Twp. 35 R. 33W

Well No. 1 Chloe Swarts

Stanolind Company

~~ABANDONED~~ Contractor

SW NE NE

E1282
SECTION PLAT

990 Ft. from N. Line

_____ Ft. from S. Line

990 Ft. from E. Line

_____ Ft. from W. Line

			4

Seward County

RECORD

Location _____

Cased _____ in., _____ ft.

Rig up _____

Sand _____

Drilling and Remarks:

Gas _____

Oil _____

Min 6224

Total Depth 6282

PRODUCTION

1st 24 hrs. Nat. _____

1st 24 hrs. after shot _____

Gas _____ Cu. Ft.

Dry Hole _____

Abandoned _____

Date

JAN 21 1948

19

S. J. LEWIS Scout


Map No. _____ Sec. 18 Twp. 35 R. 35W.

Well No. _____

Company _____

Contractor _____

SECTION PLAT

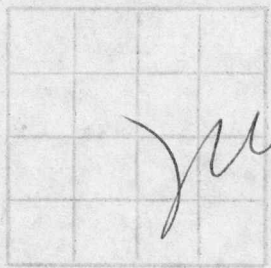

_____ Ft. from _____
_____ Ft. from S. Line
_____ Ft. from E. Line
_____ Ft. from W. Line

RECORD

Cased _____ in _____ ft.
Sand _____
Gas _____
Oil _____

Location _____
Dip _____
Dip and Remarks _____

- _____ Misc. Small Maps
- _____ Cards *Smith*
- _____ Tracing *✓*
- _____ France Map *✓*
- _____ Scarborough Map *X*
- _____ Pierce Map *✓*
- _____ Geological Dept. _____
- _____ Pierce Plat Book _____

Date _____

JUN 2 1953

Scout Cards	LP
Land Small Map	
Land Wall Map	3
Tracings	
France Map	
Pierce Map	
Misc.	

Drig. Data