


Section 17 Township 35 Range 3W

Well No. #1 Enderud Est. (B)

Company Henstadt

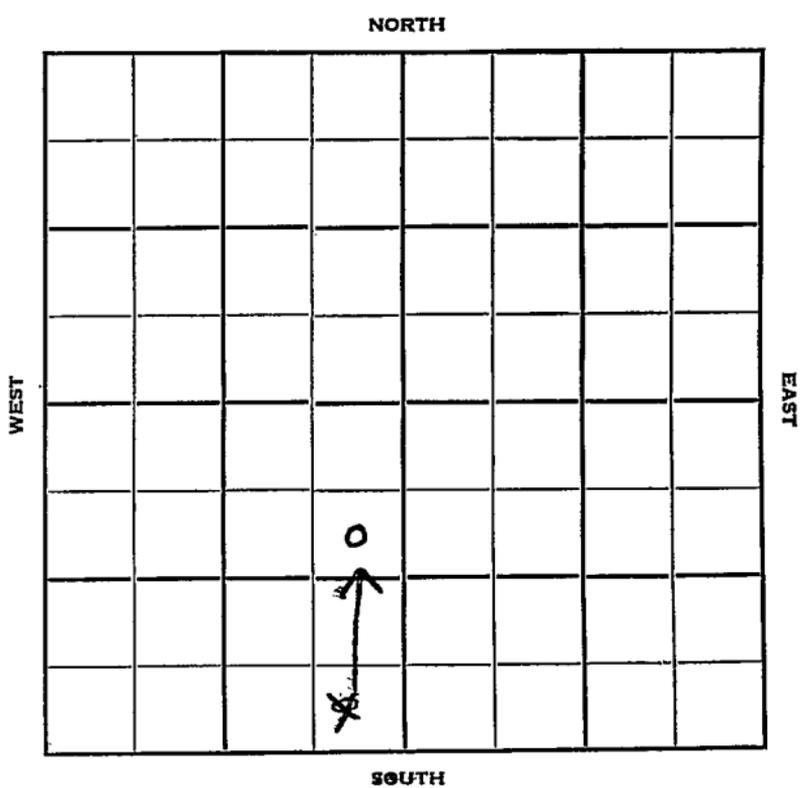

Sec. 17 Twp. 35 R. 3W

Well No. #1 Enderud Estate "B" Farm

Henstadt Company

Gabbert & Jones - Contr. Contractor


990 Ft. from N. Line

~~330'~~ Ft. from S. Line

330' Ft. from E. Line

_____ Ft. from W. Line

~~SE NE SW~~
~~SE SE SW~~

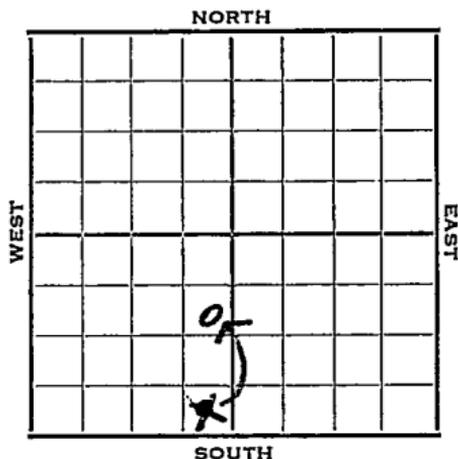

1952 Elev. 1154' REPORT

4/30 RUR

5/7 10" @ 239 Drlg. 1700'

5/14 Lans. 3756'
Drlg. 3870'

5/21 DST 4432-40, 1/2 hr. 30' OCM
1800# Drlg. 4610'

5/28 V. 4868 Simp Dol 4874
DST 4870-94 1 hr. 330' wtr
Drlg. 4894'

6/11 NR

6/18 Arb. 5088' TD 5126' 20/4384-4408
SSO & W 57/4435-56
D & A - Hold

6/25 Spud 5-1-52
D&A TD 5126
10" @ 239 Lans. 3756
DST 4432-40 opn 1/2 hr.
Rec. 30' ocm Viola 4862
Simp 4868 DST 4870-94 opn 1 hr.
Rec. 330' wtr Arb. 5088
TD 5126 20/4384-4408 SSO&W
57/4435-56 D&A

ABANDONED

Map No. _____ Sec. 17 Twp. 35 R. 3W

Well No. 1 Enderud Est. "B"

Henstadt Company



Contractor

SE NE SW

SECTION PLAT

990 Ft. from N. Line

_____ Ft. from S. Line

330 Ft. from E. Line

_____ Ft. from W. Line

Sumner County

Location _____

Rig up _____

Drilling and Remarks:

Reported

SE SE SW

RECORD

Cased _____ in., _____ ft.

Sand _____

Gas _____

Oil _____

Total Depth _____

PRODUCTION

1st 24 hrs. Nat. _____

1st 24 hrs. after shot _____

Gas _____ Cu. Ft.

Dry Hole _____

Abandoned _____

Date

MAY 14 1952 19

J. G. McGEHEE

Scout

County Summer State Kansas

Sec. 17 (Blk. Twp.) 35 (Sur. Rge.) 3W Map No.

Operator Henstadt

Well No. 1 Farm Enderud Estate "B"

Elev. 1154 Location SE NE SW

ABANDONED

990 Ft. From N Line SW

330 Ft. From E Line Quarter

1st. Report

Completion JUN 25 1952

Remarks

Gabbert & Jones - Contr.

Spudding Date 5-1-52

Drig. Data D & A TD 5126

10" @ 239 Lans. 3756 DST 4432-40

open. 1/2 hr. Rec. 30' ocm Viola 4862

Simp. 4868 DST 4870-94 open 1 hr.

Rec. 330' water Arb. 5088 TD 5126

20/ 4384-4408 SSO & W 57/ 4435-56

D & A

J. G. McGEHEE