


Section 17 Township 35 Range 3W

Well No. 3 Enderud "A"

Company Time Pet.

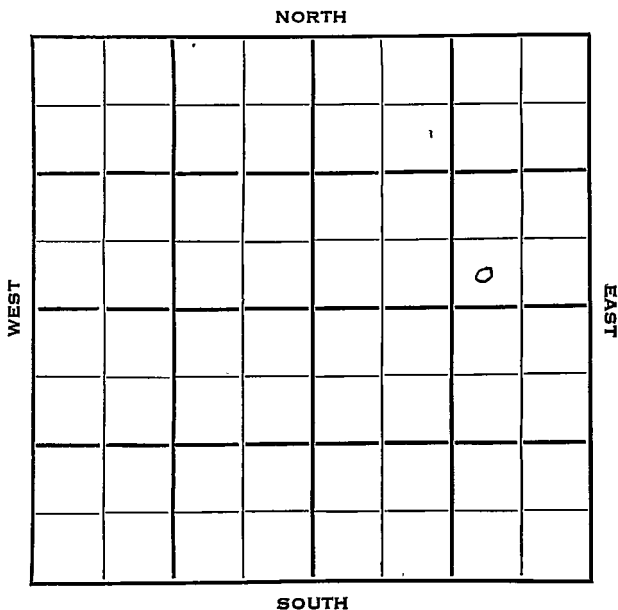

HOT FILE

Summer KANSAS

Sec. 17 Twp. 35

R. 3 W.	
Farm	
Time Petroleum	Company
Gabbert-Jones	Contractor
Caldwell Pool	

Well No. # 3 Enderud "A"

Time Petroleum

Company

Gabbert-Jones

Contractor


Caldwell Pool

Ft. from N. Line

330 Ft. from S. Line

990 Ft. from E. Line

Ft. from W. Line

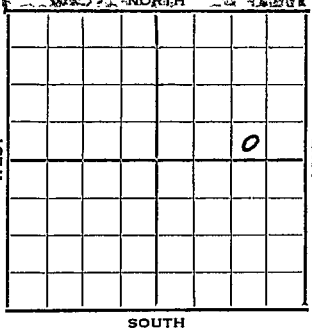

SW SE NE

MCPC acreage in Sec. 8

1953 Elev. 1125' REPORT

4/8 Spud 4-4-53
8" @ 240 Stuck @ 900

4/15 Drlg. 2910' (Ltr)

4/23 Lay 3057, KC 3701
Drlg 4371'

4/30 N.R.

5/6 Spud 4-4-53
D & A
TD 4858'
8" @ 240'
Layton 3057, KC 3702,
DST 3272-92 opn 1 hr, rec 90' o & gcm
1300#
DST 4444-60 opn 2 hr, rec 200' sw &
mud. 1875# Marm 3967, Cherokee 4114,
Miss Chat 4370, Miss Lime 4412, Kh.
4705, Chat 4758, Viola 4772, Simp dol.
4780, Simp sh. 4793, Simp sd. 4802,
TD 4858'
DST 4807-25 opn 90 min, rec 270' gas,
480' sw 1275#
DST 4807-18 opn 2 hr, rec 270' gas,
210' hgcm 480' sw 1280#
DST 4804-15 opn 2 hr, rec 215' gassy
sw 280#
D & A

ABANDONED

County Sumner State Kansas
 Sec. 17 (Blk. 35) (Sur. 3W) (Rge.) Map No.
 Operator Time Pet.
 Well No. 3 Farm Enderud "A"
 Elev. 1125 Location SW SE NE



330 Ft. From S Line NE

990 Ft. From E Line Quarter

1st. Report MAY 6 1953

Completion

Remarks Caldwell PoolGabbert-Jones - Contr.Spudding Date 4-4-53Drlg. Data D & A TD 48588" @ 240 Layton 3057 KC 3702DST 3272-92 open 1 hr. Rec. 90' o & gcm1300# DST 4444-60 open 2 hr. Rec.200' sw & mud 1875# Marm. 3967Cherokee 4114 Miss. chat 4370 Miss. lime4412 Kh. 4705 Chat 4758 Viola 4772Simp. dol. 4780 Simp. sh. 4793Simp. sd. 4802 TD 4858 DST 4807-25open 90 min. Rec. 270' gas 480' sw1275# DST 4807-18 open 2 hr.Rec. 270' gas 210' hgcm 480' sw1280# DST 4804-15 open 2 hr. Rec.225' gassy sw 280#D & A

J. G. McGEHEE