
Morton

KANSAS

SECTION 18 TOWNSHIP 35S RANGE 42W

WELL NO. #1 Heintz "B"

COMPANY Panhandle Eastern

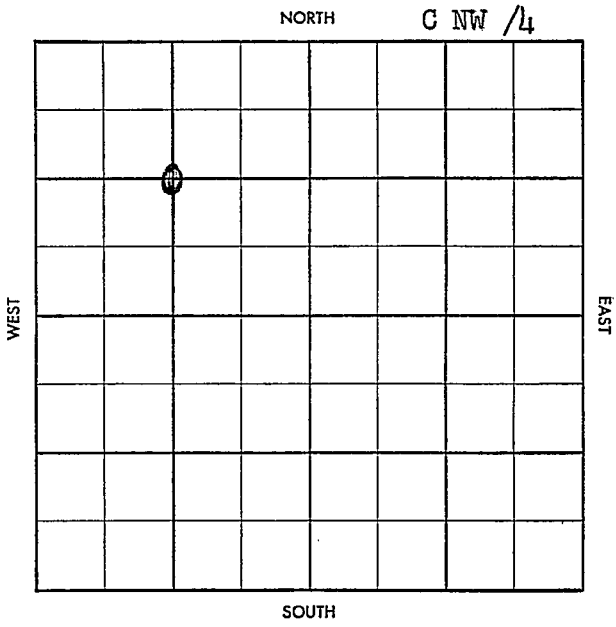

Twp. X Pool X

Co. X Feet 25

S-513-B

County Morton Elev.

Sec. 18 Twp. 35 Rge. 42W

Company Panhandle Eastern

Farm Name Heintz "B" No. 1


TOPS	DEPTH	LOG	DATUM
Anh. Waub.	2698		
Tp.	2899		
H.			
Tr.			
Dg.			
B.L.			
L.	3129		
K.C.			
B.K.C.			
Ce.			
C.			
M.			
M.			
K.			
Mz.			
Mq.			
V.			
S.			
S.			
A.			
R.			
Pf.			
G.			
T.D.	3140		

Loc. in Sec. C NW/4

Geol.

Contr. Fees Drlg.

Pool Greenwood

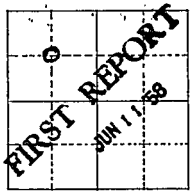

Date Comm. 5-31-58

7" @ 678/225 4" @ 3135/125

Co. Lse. No. Sec. T. R.



S-513-B

County Morton Elev. 3101 DF 3107 KB

Sec. 18 Twp. 35 Rge. 42W

Company Panhandle Eastern

Farm Name Heintz "B" No. 1

TOPS	DEPTH	LOG	DATUM
Anh. Waub.	2698		
Tp.	2899		
H.			
Tr.			
Dg.			
B.L.			
L.	3129		
K.C.			
B.K.C.			
Ce.			
C.			
M.			
M.			
K.			
Mz.			
Mq.			
V.			
S.			
S.			
A.			
R.			
Pf.			
G.			
T.D.	3140		

Loc. in Sec. C NW/4

Geol

Contr. Fees Drlg.

Pool Greenwood

ABANDONED

JUN 25 '58

Date Comm. 5-31-58

JUN 18 '58

7" @ 678/225 4" @ 3135/125

L 3098 20/2972-77 (4) $3

g swph 20/2950-60 32/2924-4

(2) $150 g sw ph 5gpa B+P 291

12/2900-06 6/2891-94 (1) $200 g

wph 55gpa ag woc JUN 25 '58

2860-64 12/2844-50 28/2827-4

(1) $50 g oc sw ph Ngpa

D-6A