


Section 18 Township 35 Range 40WWell No. #1 Goddard "C"Company Cities Service

NORTH

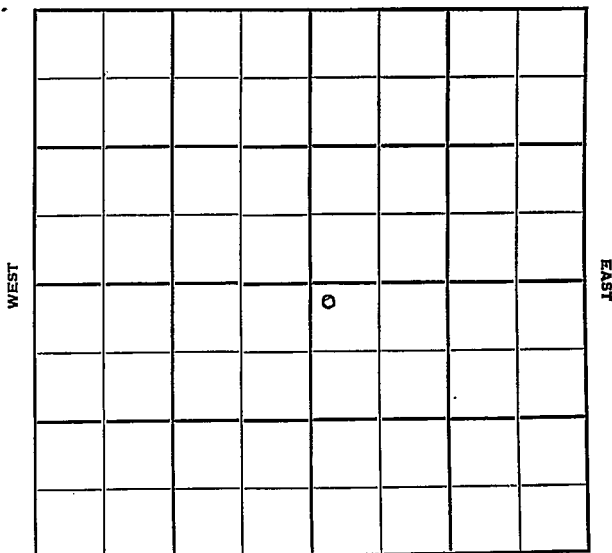

SOUTH

Morton ~~KANSAS~~

Sec. 18 Twp. 35 R. 40W

Well No. #1 Goddard "G" Farm

Cities Service Company

Hugoton Pool Contractor


100' Ft. from N. Line

 Ft. from S. Line

 Ft. from E. Line

100' Ft. from W. Line

NW SE

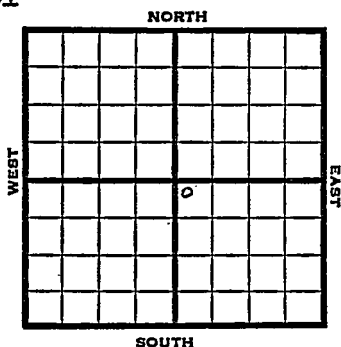

1951

Elev. 3437'

REPORT

5/2

Spud 4-29-51
8" @ 370
WOC


6/6

Spud 4-29-51
Gas well TD 2665' 8" @ 370'
7" @ 2665' TD 2665'
Her. 2504' Krider 2522' Win 2610'
CO to 2651' 70/2624-28' 50/2610-20
50/2574-84 10/2568-70 120/2540-64
20/2532-36 14,000 A
Comp. 16,150,000 gas 416#

COMPLETED

J. E. TYRA

County Morton State Kansas
 Sec. 18 (Blk. 35) (Sur. 40W) (Twp. Map No.)
 Operator Cities Service
 Well No. 1 Farm Goddard "C"
 Elev. 3437 Location NW SE

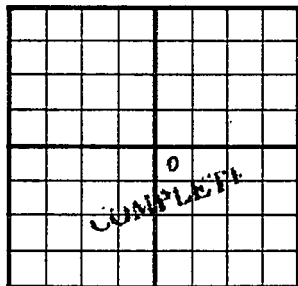

100 Ft. From N Line SE
100 Ft. From W Line Quarter
 Ist. Report
 Completion JUN 6 1951
 Remarks Hugoton Pool
 Spudding Date 4-29-51

Drlg. Data Gas well TD 2665
8" @ 370 7" @ 2665 TD 2665
Her. 2504 Krider 2522 Win. 2610
CO to 2651 70/ 2624-28 50/ 2610-20
50/ 2574-84 10/ 2568-70 120/ 2540-64
20/ 2532-36 14000 A
Comp. 16,150,000 gas 416#

J. E. TYRA