


Section 18 Township 35 Range 34W

Well No. #1 Hilbig

Company Plains Natural

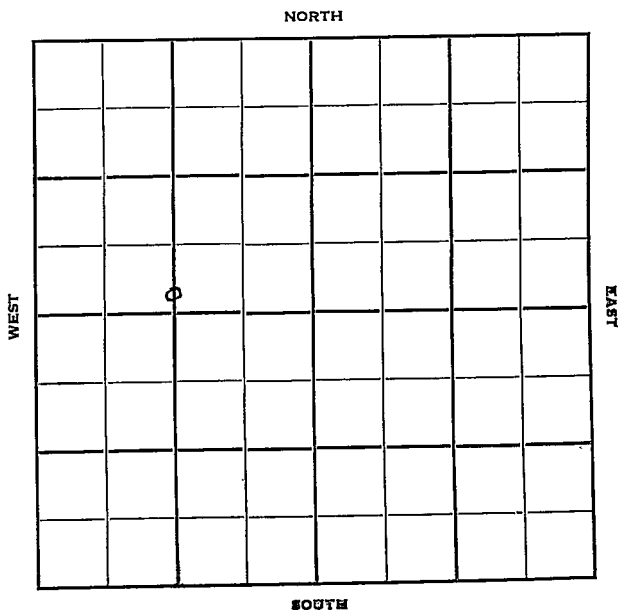

Sec. 18 Twp. 35 R. 34-W

Well No. #1 Hilbig Farm

Plains Natural Company

Contractor

Hugoton


2440 Ft. from N. Line

_____ Ft. from S. Line

_____ Ft. from E. Line

1320 Ft. from W. Line

C S L S $\frac{1}{2}$ nW

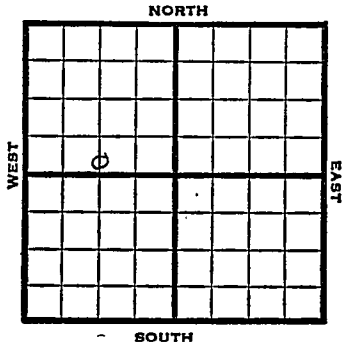

1950

Elev 2949

REPORT

10/18

Location

11/22

Spud 10-21-50

10" @ 676

Hol 2614

Her 2679

Krider 2713

TD 2761

7" @ 2753

30/2745-50, 30/2729-34, 30/2721-26

30/2714-19, 120/2680-2800

12000 A

Comp 1,523,000 gas 423#

Completed

COMPLETED

