

O.W.W.O.

FORM 51 5M PETROL


KANSAS


Seward

Section 18 Township 35 Range 31-W

Well No. #1 Loflind-Hawks

Company Huber Corp.  
~~H. B. Hunt~~

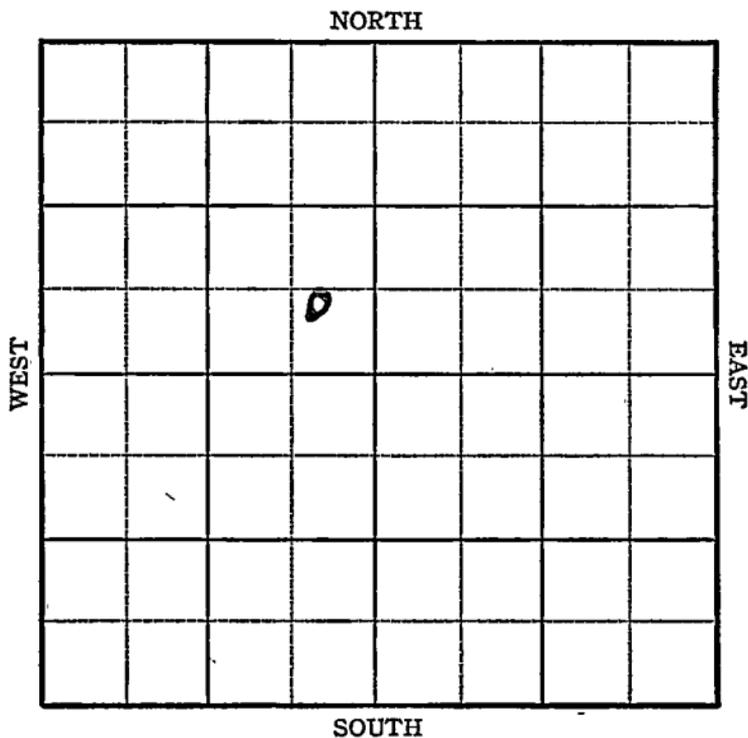


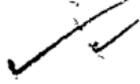

Sec. 18 Twp. 35 R. 31W

Well No. #1 Loflind - HAWKS Farm  
Huber Corp.  
H. L. Hunt Company

Hugoton  
 \_\_\_\_\_ Ft. from N. Line  
600 Ft. from S. Line  
 \_\_\_\_\_ Ft. from E. Line  
2000 Ft. from W. Line  
 SE NW

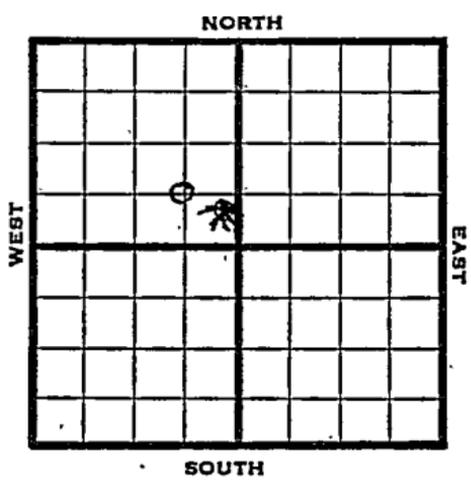

1946 REPORT

2/27	421' fsg.	
3/7	13" - 600'	
	Drlg. 700'	
3/14	Drlg. 1765'	
3/21	Drlg. 2349'	
3/28	SD 2364' repairs.	
4/4	Drlg. 2378'	
4/10	Drlg 2950	
4/16	Drlg 3740	
4/23	Lans 4466 or 4490 ?	
	Drlg 4553'	
5/1	Drlg 5000'	
5/7	Drlg 5365'	
5/14	" "	
5/21	Drlg 5900'	
5/29	Drlg. 6000' ?	
6/5	Drlg. 6475'	
6/12	" "	
6/18	Drlg 7000'	
6/26	" "	
7/3	" "	
7/9	" "	
7/16	TD-8006' - in Perf	
7/23	Holen. 2570	Herington 2640
	Winef. 2685	Ft. Riley 2855
	BFW2980	Lans 4555

OVER

1946

Cont'd

7/23 Miss 6230'  
B-Miss 7780                      Simp 7985  
TD 8006'  
7/30        "                      "                      "  
8/7        Simp. 7985  
TD 8006'

### ABANDONED

1951

### O.W.W.O.

5/9        Lans. 4535'        Morrow 5927', Sand 6146  
Miss. 6210', St. Gen. 6560',  
Fredonia 6680', St. Lewis 6807',  
Spurgeon 6925', Warsaw 7145', Osage  
7315', Kinderhook 7680', Maq. 7770',  
Viola 7850', Simp 7970',  
O TD 8005'  
To test Morrow sand

7/18        Gas Well        TD 6337  
Lans. 4535        Morrow 5927        Sand 6146  
Miss 6210        St. Gen. 6560  
Fredonia 6680        St. Lewis 6807  
Spurgeon 6925        Warsaw 7145  
Osage 7315        Kh 7680  
Maq 7770        Viola 7850  
Simp. 7970        Oyd 8005  
CO to 6337  
128/6272-88        1000 A 160/5995-6015  
DST 5975-6337        opn 3½ hr. Rec. 2 mcf/g  
40' dist. 250 A        Test 5,450,000 gas  
250 A        Test 4,650,000 gas        250 A  
Test 2,300,000 gas        250 A        Test same  
Comp. opn flow/3,549,000 gas  
14 bbl. dist pr million        SIP 1553#

### COMPLETED

KANSAS

Kansas Pool Name HugotonMap No. No map Sec. 18 Twp. 35 R. 31WWell No. 1 LoflindH. L. Hunt

Company

**FIRST REPORT**

Contractor

SE NW

## SECTION PLAT

		o	

         Ft. from N. Line600 Ft. from S. Line         Ft. from E. Line2000 Ft. from W. Line

Seward County

Location         Rig up         

Drilling and Remarks:

421 fsg.

## RECORD

Cased          in          ft.Sand         Gas         Oil         Total Depth         

## PRODUCTION

1st 24 hrs. Nat.         1st 24 hrs. after shot         Gas          Cu. Ft.Dry Hole         Abandoned         

Date

FEB 27 1946

19

S. J. LEWIS

Scout

BRIT.

*no*

Misc. Small Maps	<i>CA</i>
Cards	<i>Sarathey</i>
Tracing	<i>[scribble]</i>
France Map	<i>[scribble]</i>
Scarborough Map	<i>X</i>
Pierce Map	<i>[scribble]</i>
Geological Dept.	
Pierce Plat Book	

**KANSAS** Pool Name Hutoton  
 Map No. \_\_\_\_\_ Sec. 18 Twp. 35 R. 31W

Well No. 1 Loflind  
H. L. Hunt Company

**ABANDONED** Contractor \_\_\_\_\_  
 SE NW *E 1, 2, 7, 13*  
**SECTION PLAT**

\_\_\_\_\_ Ft. from N. Line  
600 Ft. from S. Line  
 \_\_\_\_\_ Ft. from E. Line  
2000 Ft. from W. Line


Seward County

Location \_\_\_\_\_  
 Rig up \_\_\_\_\_  
 Drilling and Remarks:

*Comp 7785*

**RECORD**

Cased \_\_\_\_\_ in., \_\_\_\_\_ ft.  
 Sand \_\_\_\_\_  
 Gas \_\_\_\_\_  
 Oil \_\_\_\_\_  
 Total Depth 7006

**PRODUCTION**

1st 24 hrs. Nat. \_\_\_\_\_  
 1st 24 hrs. after shot \_\_\_\_\_  
 Gas \_\_\_\_\_ Cu. Ft.  
 Dry Hole \_\_\_\_\_  
 Abandoned \_\_\_\_\_

Date \_\_\_\_\_  
AUG 7 1946 19 \_\_\_\_\_ S. J. LEWIS Scout

*no* *well*

Misc. Small Maps	<del>✓</del>
Cards	<i>Lorothy</i>
Treeing	<i>✓</i>
France Map	<i>✓</i>
Scarborough Map	<del>✓</del>
Pierce Map	<i>✓</i>
Geological Dept.	_____
Barco Flat Book	_____


County **Seward** State **Kansas**

Sec. **18** (Blk. Twp.) **35** (Sur. Rge.) **31W** Map No.

Operator **Huber Corp.**

Well No. **1** Farm **Lofland - Hawks**

Elev. **2713** Location **C SE NW**

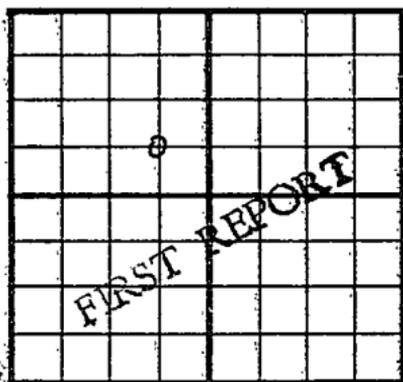

660 Ft. From **S** Line **NW**

660 Ft. From **E** Line **Quarter**

1st. Report **MAY 9 1951**

Completion

Remarks **O.W.W.O.**

Spudding Date **O.W.W.O.**

Drlg. Data

**Lans. 4535 Morrow 5927 Sand 6146**

**Miss. 6210 St. gen. 6560 Fredonia 6680**

**St. Lewis 6807 Spurgeon 6925 Warsaw 7145**

**Osage 7315 Kinderhook 7680 Maq. 7770**

**Viola 7850 Simp. 7970 OTD 8005**


**to test Morrow sand**

Scout Cards	<i>mm</i>
Land Sheet Map	
Land Wall Map	<i>3P</i>
Tracings	
France Map	
Pierce Map	
Misc	

MAY 11 1951

Prig. Data

County Seward State Kansas  
 Sec. 18 (Blk. 35) (Sur. 31W) (Twp.) (Rge.) Map No.  
 Operator Huber Corp.  
 Well No. 1 Farm Lofland - Hawks  
 Elev. 2713 Location C SE NW

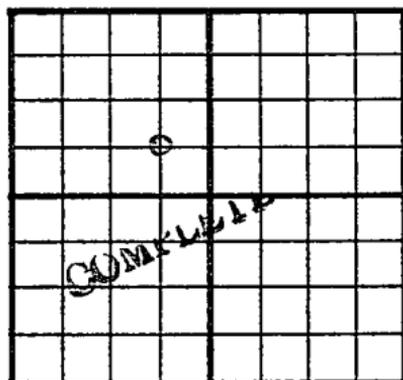

660 Ft. From S Line NW  
660 Ft. From E Line Quarter  
 1st. Report  
 Completion JUL 18 1951  
 Remarks OWWO  
 Spudding Date

Drlg. Data Gas well TD 6337  
Lans. 4535 Morrow 5927 Sand 6146  
Miss. 6210 St. Gen. 6560 Fredonia 6680  
St. Lewis 6807 Spurgeon 6925 Warsaw 7145  
Osage 7315 Kh. 7680 Maq. 7770 Viola  
7850 Simp. 7970 OYD 8005 CO to 6337  
128/ 6272-88 1000 A 160/ 5995-6015  
DST 5975-6337 open 3½ hr. Rec. 2 mcfg  
40' dist. 250 A test 5,450,000 gas  
250 A test 4,650,000 gas 250 A  
test 2,300,000 gas 250 A test same  
Comp. open flow/ 3,549,000 gas  
14 bbl. dist per million SIP 1553#

J. E. TYRA

25 1957

Scout Cards	.....
Land Snail Map	.....
Land Wall Map	..... 3
Tracings	.....
France Map	.....
Pierce Map	.....
Misc.	.....