

DX 78-1


Morton

KANSAS

Section 2 Township 35 Range 42W

Well No. #1 Hall "T"

Company Cities Service

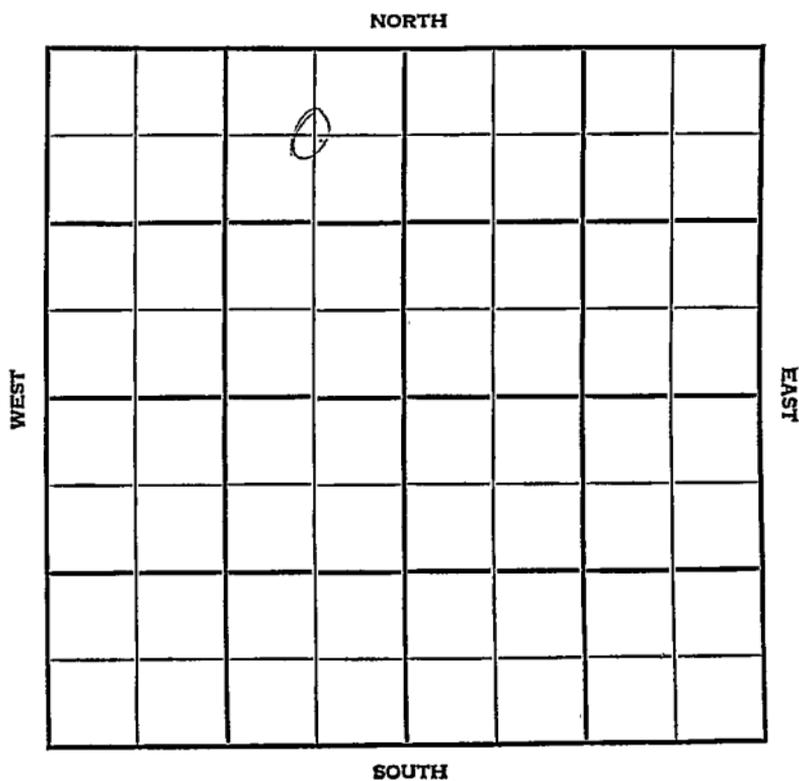

County Morton Elev. _____
 Sec. 2 Twp. 35 Rgs. 42W
 Company Cities Service
 Farm Name Hall #111 No. 1

TOPS	DEPTH	LOG	DATUM
Anh.			
TP.			
H.			
Tr.			
Dg.			
Bl.			
L.			
K.C.			
B.K.C.			
Ce.			
C.			
M.			
M.			
K.			
Mz.			
Ma.			
V.			
S.			
S.			
A.			
R.			
PE.			
G.			
T.D.			

Loc. in Sec. C NE NW
 Geol. _____
 Contr. _____
Rine Drlg.
 Pool Greenwood

	0	
FIRST REPORT		
	JAN 9 57	

Date Comm. _____
 Location _____

~~34~~

Co.
 Sec.
 T.
 R.

34

County Morton Elev. 950
 Sec. 2 Twp. 35 Rge. 42W
 Company Cities Service
 Farm Name HART 11TH No. 1

Co.

TOPS	DEPTH	LOG	DATUM
Arb. <u>W36</u>		<u>2674</u>	
Tr.	<u>2880</u>	<u>2870</u>	
H.		<u>3192</u>	
Tr.			
Dg.			
Bl.			
L.		<u>3310</u>	
K.C. <u>Manna</u>		<u>3870</u>	
B.K.C.			
Ce. <u>MW 5D</u>		<u>4178</u>	
C. <u>" 5D</u>		<u>4532-4V</u>	
M.			
M.			
K.			
Mz.			
Mo.			
V.			
S.			
S.			
A.			
R.			
PE.			
G.			
T.D.	<u>4591</u>		

Loc. in Sec. C NE NW
 Geol. _____
 Contr. _____
 Pipe Drlg. _____
 Pool Greenwood

COMPLETE		
FEB 27 '57		

Loc.

No.

Date Comm. _____
 Location JAN 15 1-10-57 859
1833/700 JAN 30 4020 JAN 30 ?
DST 4267-4311 40 20" net
5' Md BHP 15/15" DST 4533
-46 90" G/70" net 90' 0 2' 6 CM
+ 210' oil FP 35-70 BHP 945/1
5/2 @ 4589/200 FEB 6 '57 WOCT FEB 13 '57
CO 16/4534-38 2 \$ 3
BOPH no time ^{frac} Flwd 132 BO

Sec.

T.

R.

E.

+ ~~746~~ .3 Bwin 6 hrs +

9a 75 MFG FEB 27 '58

Ph Flw 234 Bopd nola

graw 42.8°